

DUNE FD2 PDS Cold Box #1 as built Grounding, Shielding, and Cabling

Introduction

This document is the *as built* description for the DUNE Far Detector 2 (FD2) Photon Detector System (PDS) Cold Box #1 prototype. This document also defines the plans and methods for implementing grounding and shielding to ensure that the safety requirements are met, and to ensure that the noise performance of the detector and instrumentation meet experimental goals. The broad strategy is to optically isolate the cathode, have all conductive paths between components insulated and shielded, and for there to be no conductive components left floating without a reference voltage.

Here are the definitions of key terms in this document:


1. *Ground* is a general term that refers to a reference conductor that serves as a common potential for a specific circuit, subsystem, or facility. As there can be different kinds of grounds or ground references in an experiment, this document aims to be verbose when describing a reference.
2. *Shielding* refers to the application of metallic surfaces that interrupt the flow of electromagnetic energy, either radiated or conducted, to isolate sensitive circuits or conductors from the effects of interference. Generally, shields do not carry any signal current, although they may in certain circumstances.
3. *Common* is a term that is used to describe the local electrical reference node or net or plane for a circuit or set of circuits. It is often called “ground” or “ground plane” in a schematic or electronics design, although there may or may not be a direct connection to ground or Earth in the system. It is also often taken to be the “0 Volt Reference” for a circuit or system. When multiple power supplies are used in a circuit or system, often the power returns of the supplies are connected to this common node or plane.
4. *Safety Ground* refers to the system of conductors and equipment ground connections that provide a connection to the Earth Ground or the Grounding Electrode for the purpose of ensuring that hazardous electrical energy has a shunt path to Earth and away from personnel in the case of a fault.
5. *Detector Ground* refers to the system of conductors and connections that provide a reference or common for the sensitive instrumentation of the experiment. There are often certain noise requirements for this network that require special treatment. It is often distinguished from *Safety Ground* in HEP detector instrumentation systems, although the NEC places requirements on how this is connected and configured. In DUNE, warm detector components, including racks

and crates, are generally referenced to *Detector Ground*. The cryostat itself is also *Detector Ground*.

6. *Cathode Mesh Reference* refers to the connection to a conductive portion of the cathode mesh. In cathode cells where the FD2 PDS modules are installed, the mesh covering the top and bottom of the cathode FRP structure is anticipated to be conductive (i.e., not resistive) for the 74cm x 65cm region of a cathode cell. A cage is formed between the top and bottom conductive mesh coverings and the M4 conductive screws securing the mesh around the perimeter of each cell. When the cathode HV is active, the cathode mesh charges up to -30kV at the Cold Box tests and -300kV at DUNE relative to the *Cryostat Reference*.
7. *Field Cage Rib Reference* refers to the connection to a rib of the field cage. The field cage is constructed of ribs, which are large conductive rings, isolated from each other and stacked between the anode and cathode and then again to the other anode. Each rib steps the cathode voltage in a controlled gradient up to the anode voltage (e.g., steps of 15kV).


FD2 PDS System Diagram

The diagram below shows the system level view of the connection types and references in the FD2 PDS. All copper cables are shielded with the shield connected to the landing location on one or both sides.

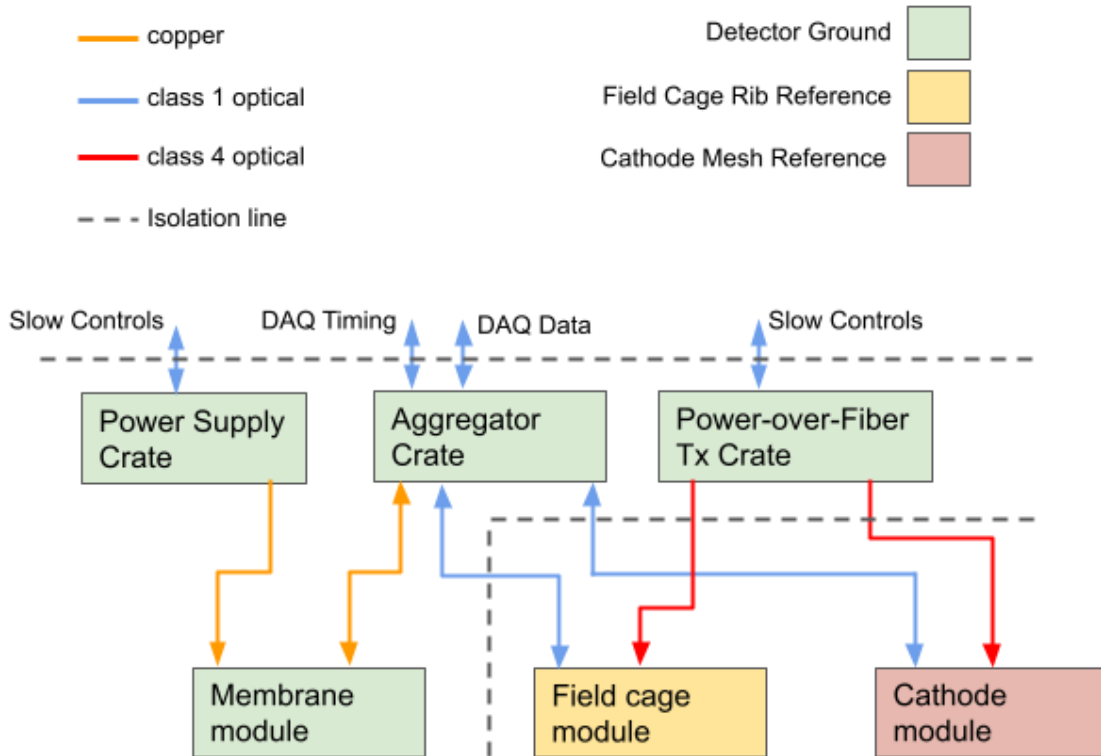


FD2 PDS Cold Box Cathode Module

The installation plan for a cathode-style module electronics cell and detector cell for the FD2 PDS at Cold Box 1 is shown in the capture below. There are two cathode module instances installed for Cold Box 1.

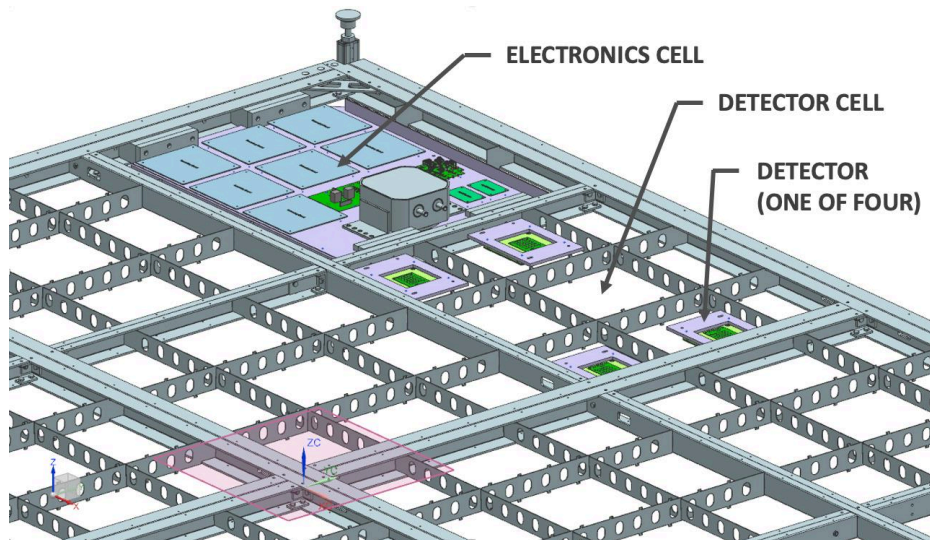


The electronics cell is comprised of an aluminum plate installed in the cathode by interfacing mounting blocks made of G10. The aluminum plate is isolated from the mesh by G10 ribs supporting the mesh. The layout of the Cold Box Test 1 FD2 PDS electronics plate is shown in the capture below:

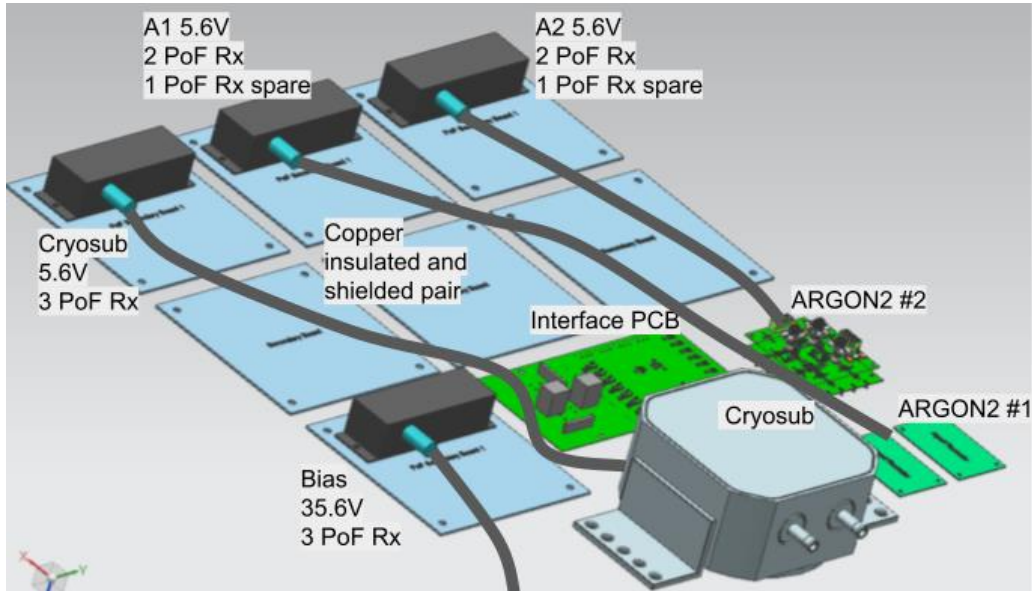


In the above capture, the four power-over-fiber modules are shown with their destination copper leads. Three class 4 fiber arrive at each power-over-fiber module to deliver the optical power for conversion.

The optical fibers for power and output signal result in the PDS cathode installation being completely isolated from Detector ground. The cathode-style modules are instead referenced to the cathode mesh.

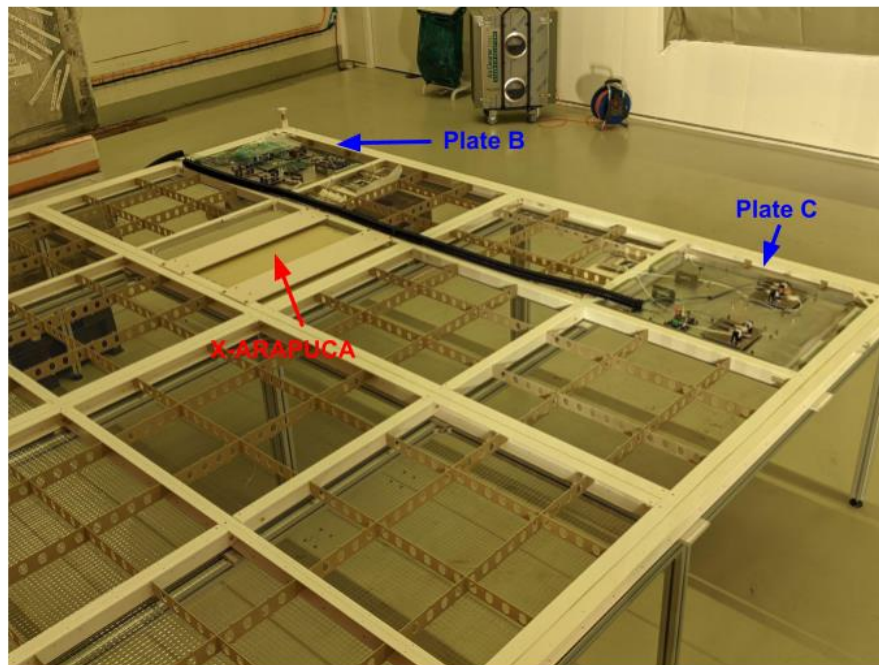

To assess any potential for noise contamination in the warm racks, a spectral analysis was conducted of the custom power-over-fiber laser transmitter unit for Cold Box 1. Shown below is the custom unit:

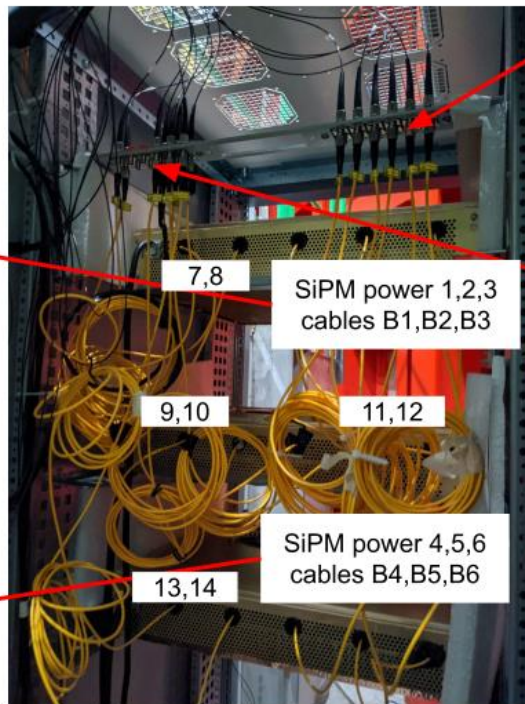

B1,2,3,4,5,6
L → R

Back L → R
8,10,12,14

Front L → R
7,9,11,13

7,8

SiPM power 1,2,3
cables B1,B2,B3


9,10

11,12


SiPM power 4,5,6
cables B4,B5,B6

13,14

Shown below is the measurement taken at 1 foot with the unit on. A Keysight MXR404A Mixed Signal Oscilloscope was used for this measurement.

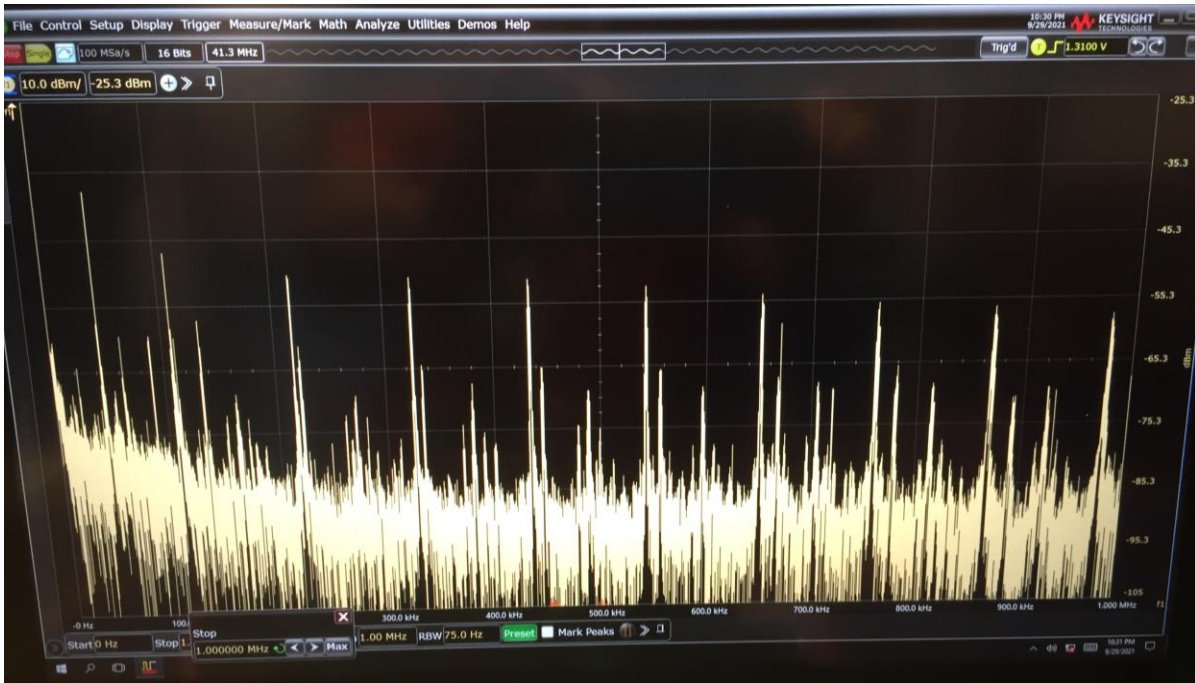


The following image is the measurement taken at 1 foot with the unit off.

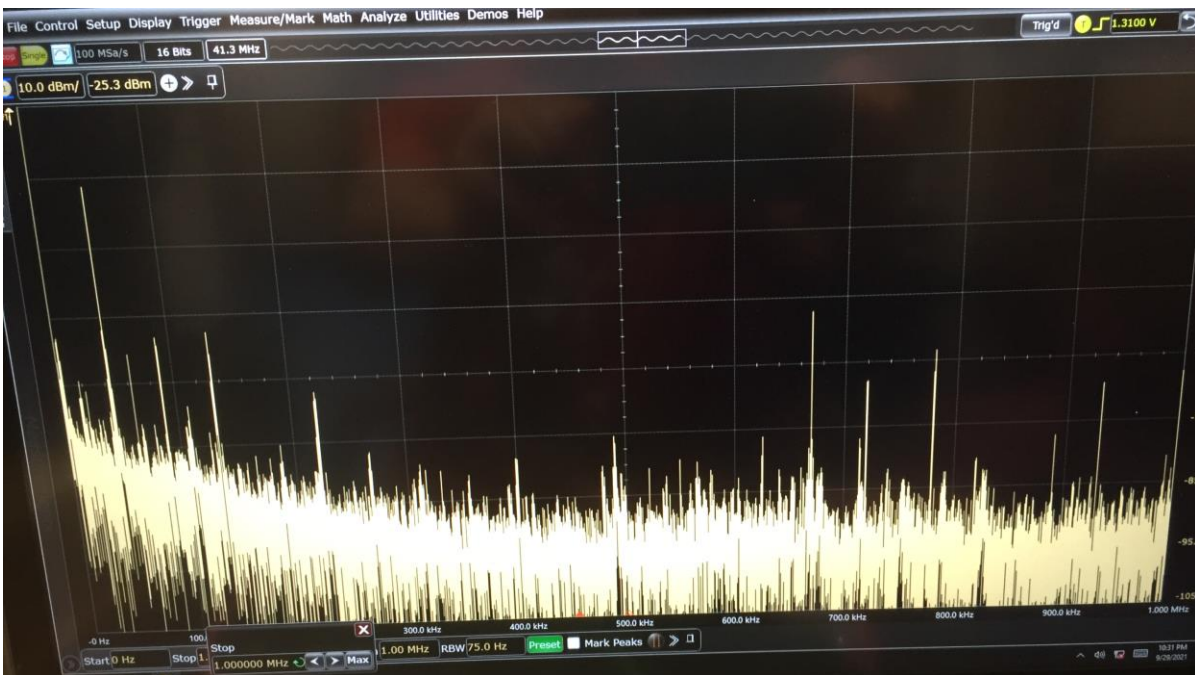


The noise from the custom power-over-fiber laser transmitter unit for Cold Box 1 is primarily observed to be the 100kHz switching noise. The custom box consists of two power supplies, five lasers, and

supporting hardware. The switching power supplies in the unit generate harmonics at that switching frequency. The results match expectations.


The schematic below shows the plan to tie the return leads to the aluminum plate reference through a 1 megaohm resistor to prevent the power-over-fiber module copper leads from floating:

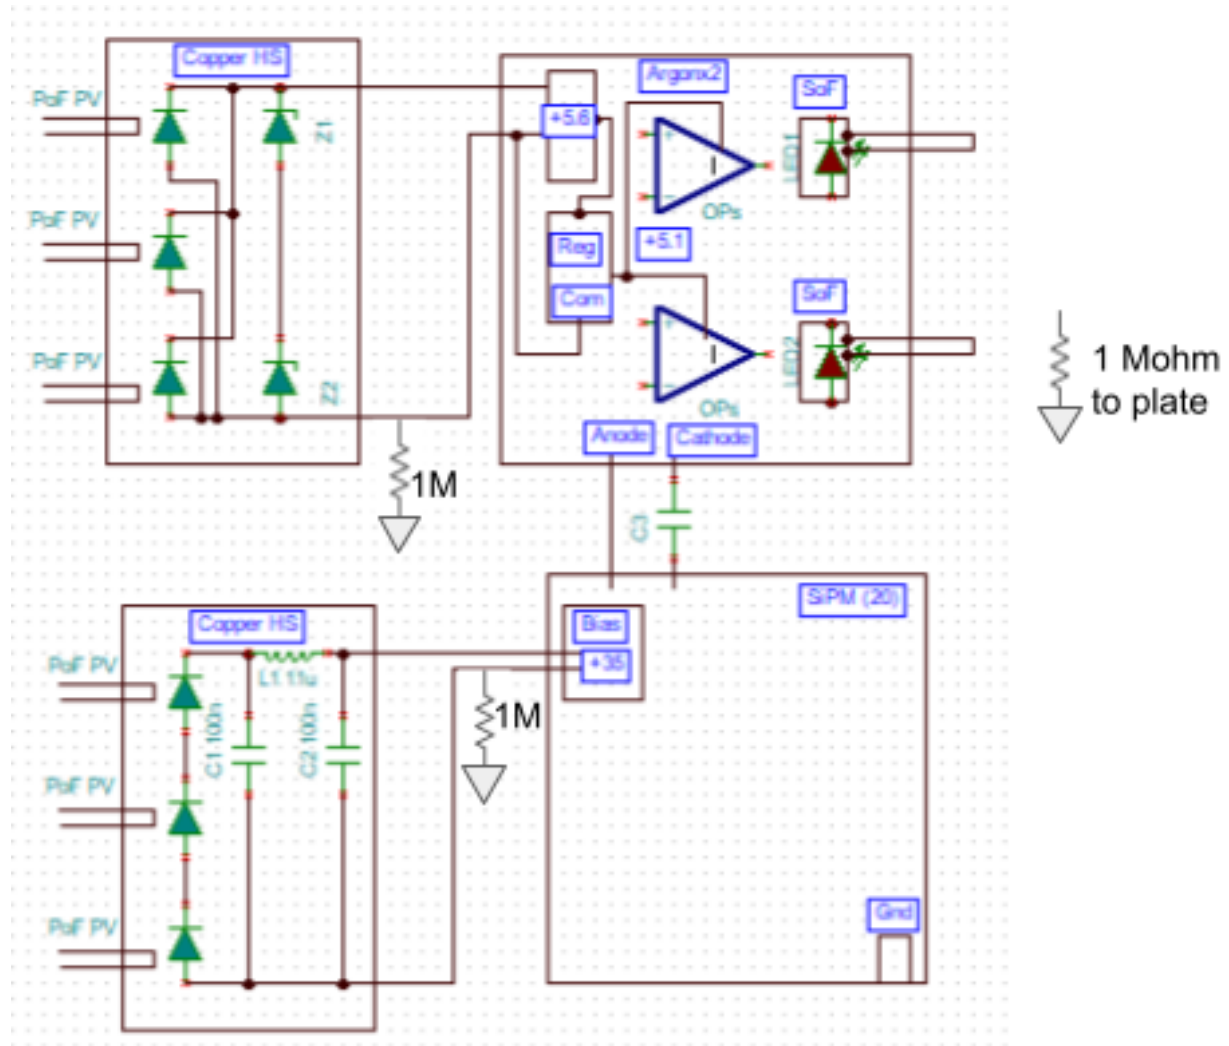

The aluminum plate is connected to the Cathode Mesh Reference at one location as shown in the capture below:

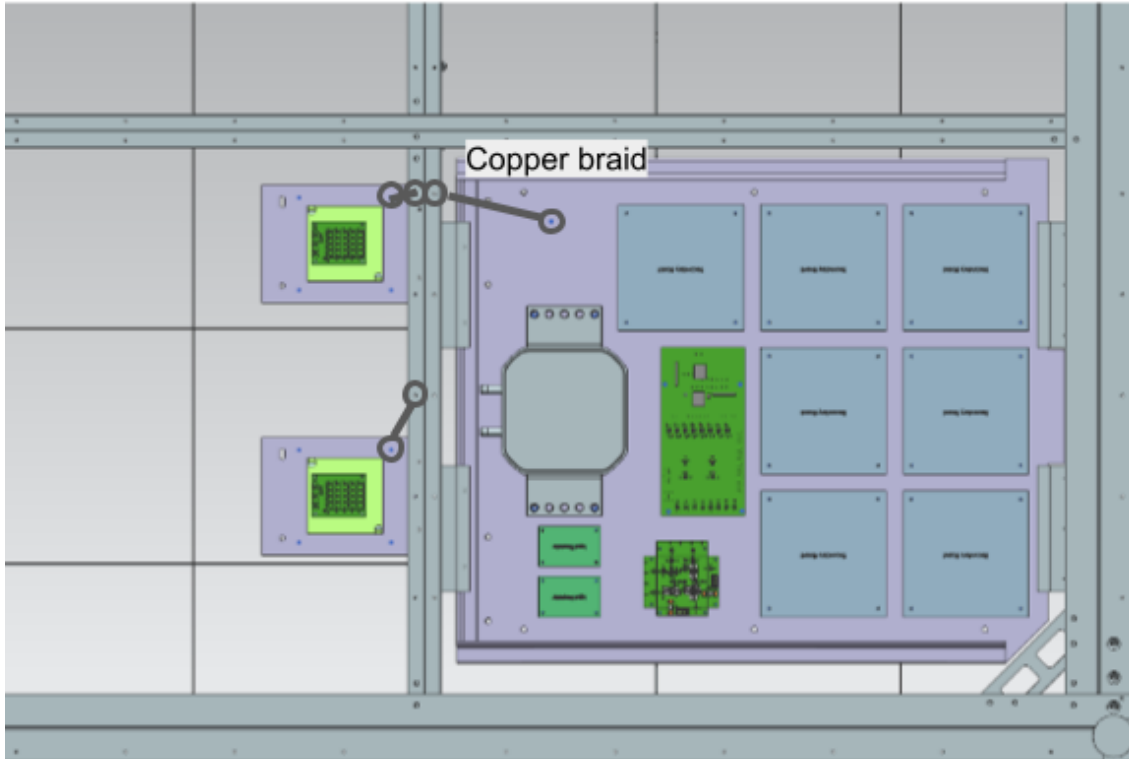

The +35V bias power-over-fiber module will fanout the bias to the mini-ARAPUCAs and, potentially, xARAPUCA through the Interface PCB as shown in the capture below:

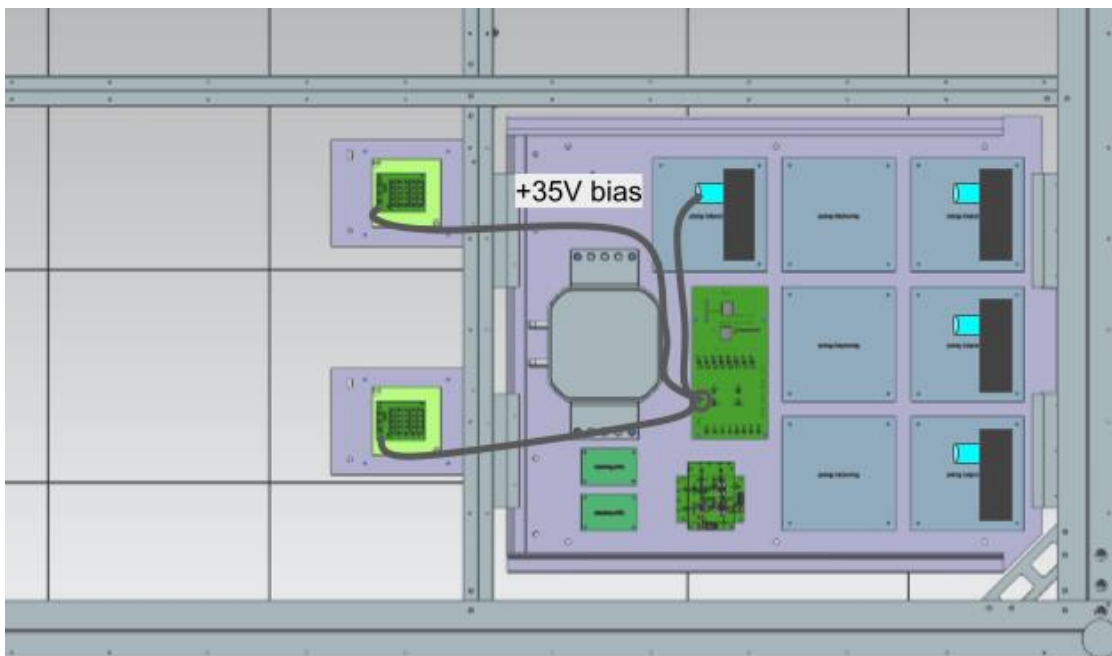

The schematics for the ARGON2 analog readout and the Interface PCB are attached at the end of this document.

PLATE C



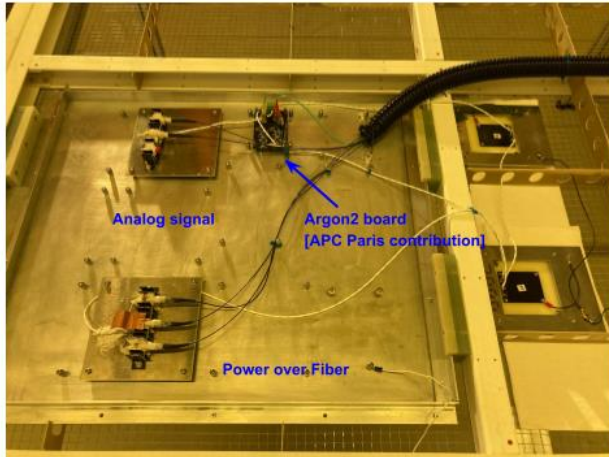


PLATE B

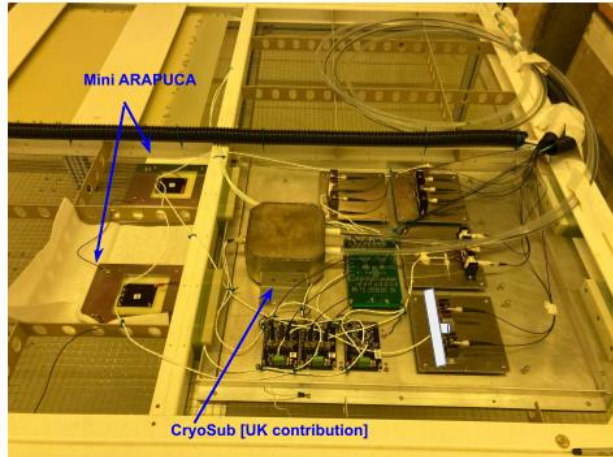


A grounding and shielding block diagram for one cathode readout channel is given in the image below:

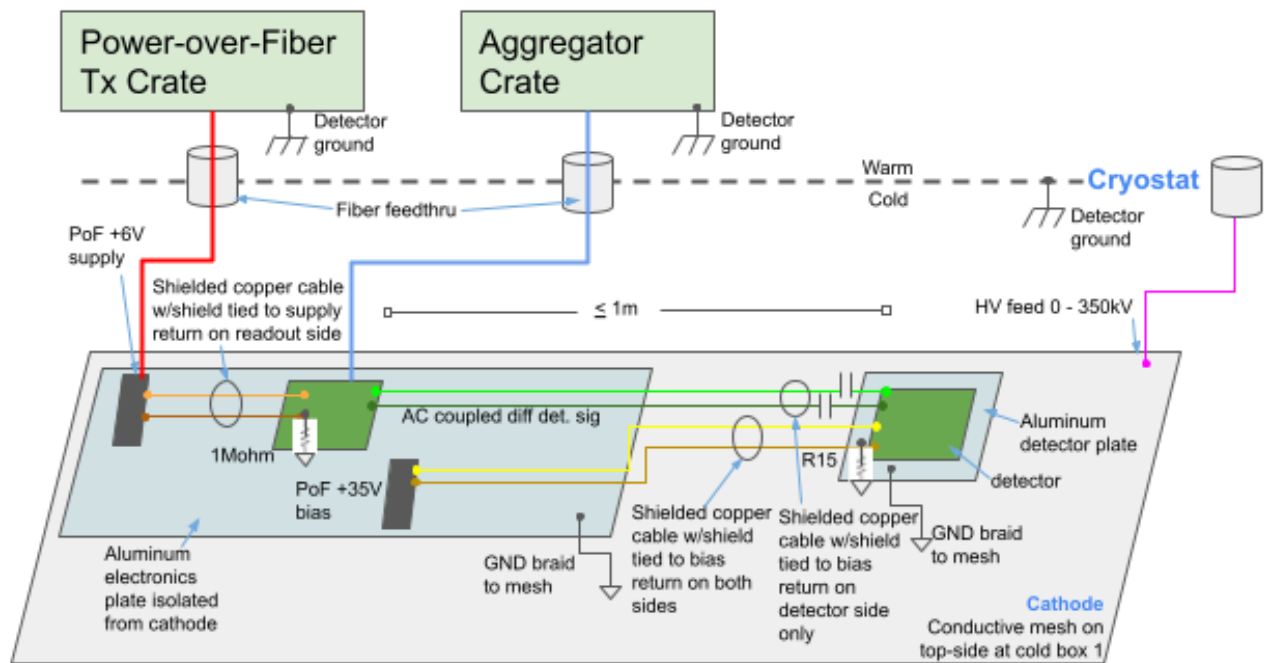


FD2 PDS Cold Box Membrane Module


The installation plan for a membrane-style module electronics cell and detector cell for the FD2 PDS at Cold Box 1 is shown in the capture below. There is one membrane module instances planned for Cold Box 1.

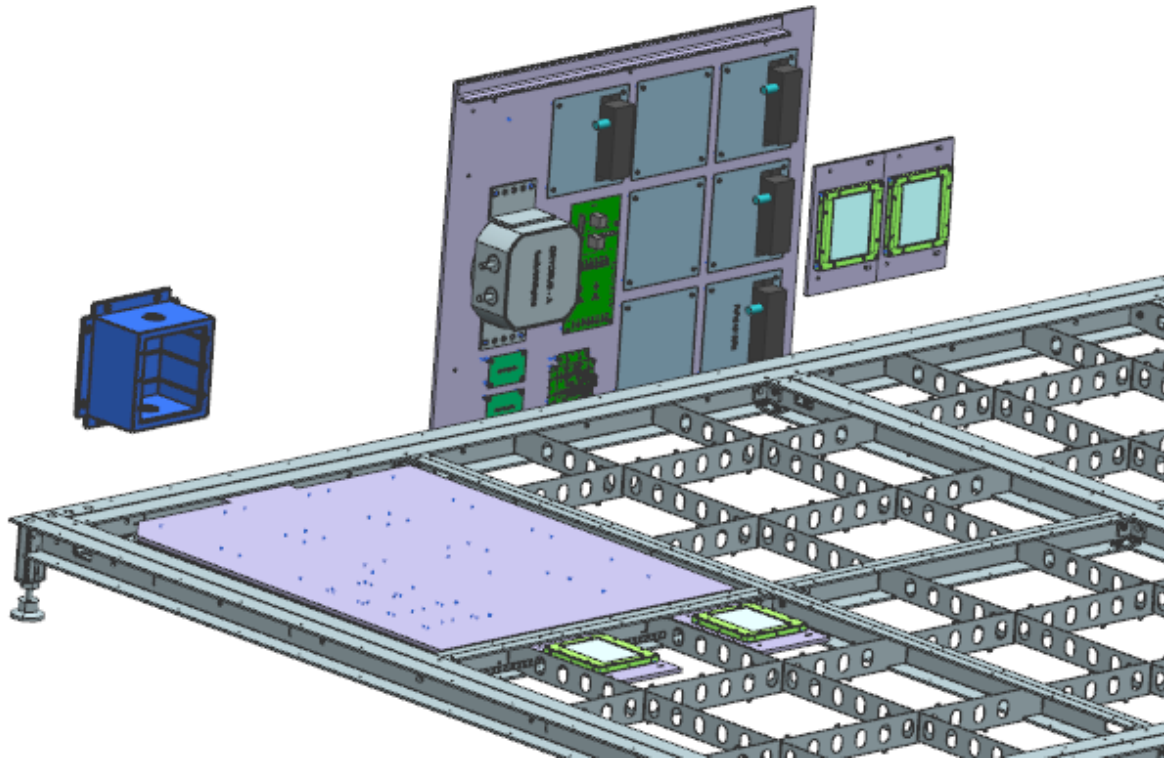

The membrane-style module has the same components as the cathode-style module except for power is delivered over copper, rather than fiber.

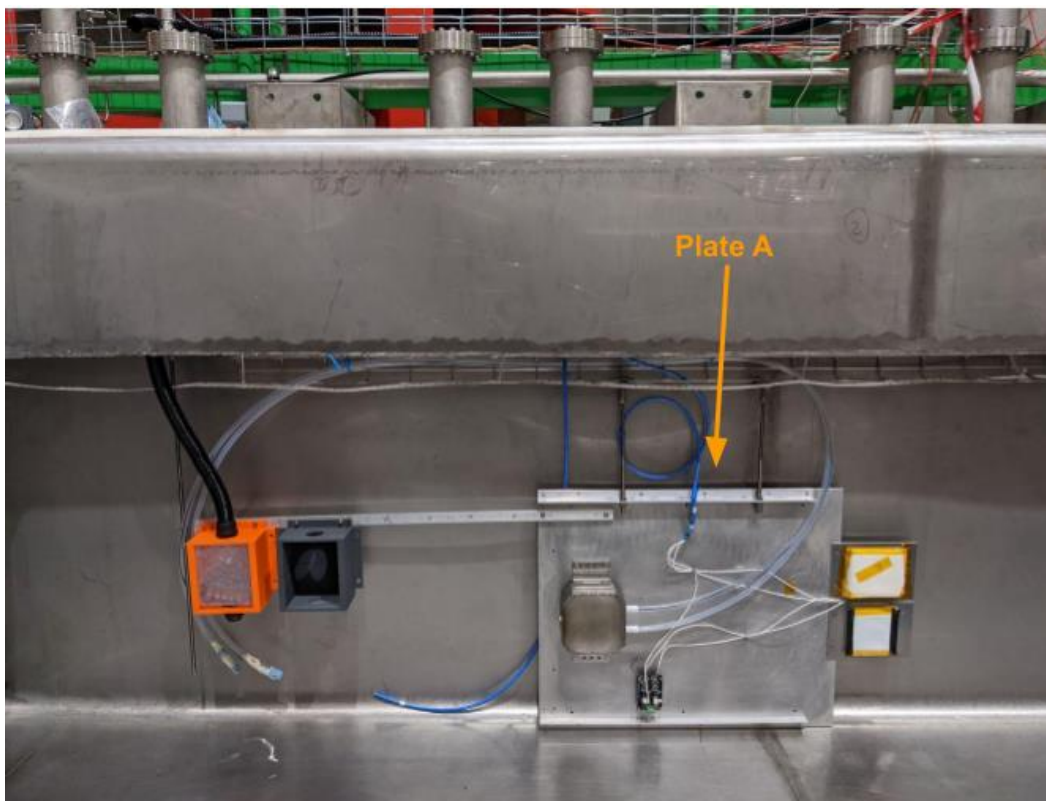


Below is a grounding and shielding block diagram representing the membrane Cold Box 1 installation:

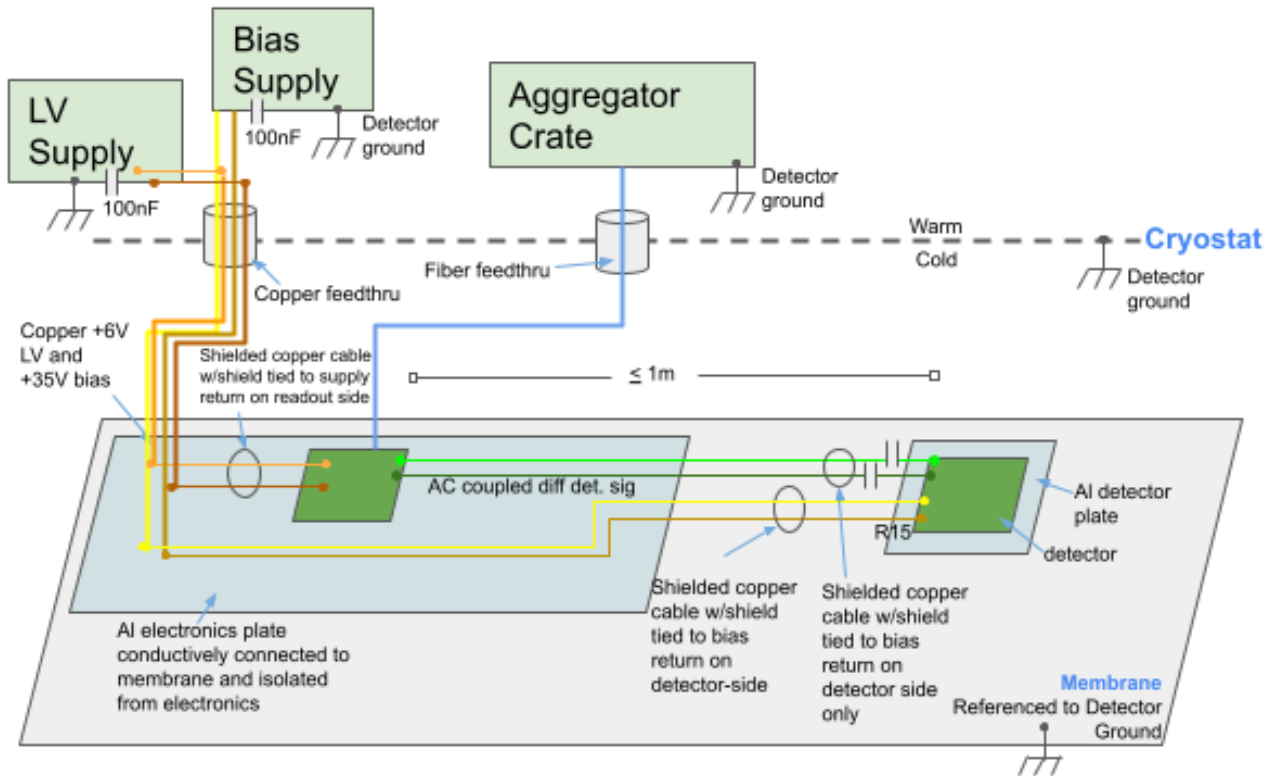

FD2 PDS Additional Components


A passive LED flasher system was installed from ProtoDUNE-SP run 1:

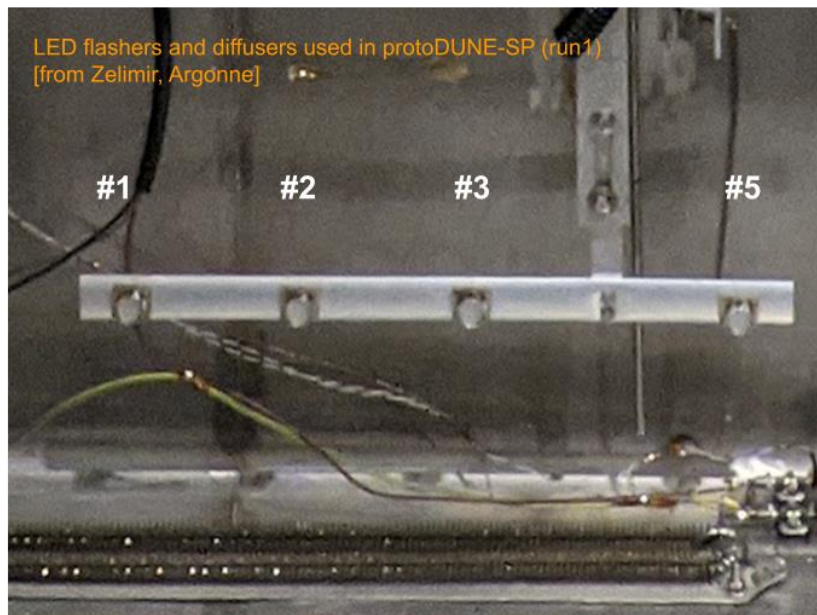

The Cryosub vacuum housing mounts on top of the cryostat to a dedicated flange, which is on detector ground and a vacuum pump is required to be connected to the flange for steady-state operation. If the Cryosub pump connection is conductive then care should be taken to plug it into detector ground, to avoid creating an inadvertent path to detector ground. For example, if the vacuum pump power is referenced to building/safety ground, then a conductive path is created to detector ground through conductive vacuum connector; in this case, the nonconductive connector should be installed. The cathode fiber disconnects will occur at FC couplers at the power-over-fiber coupler box and at a secondary plate on the membrane installation.

Below is the Cryosub vacuum housing assembly diagram. The Burst disc is a critical safety feature for overpressure events. Please contact the Croysub technical leads before modifying the Cryosub vacuum assembly.

Vacuum Assembly Diagram

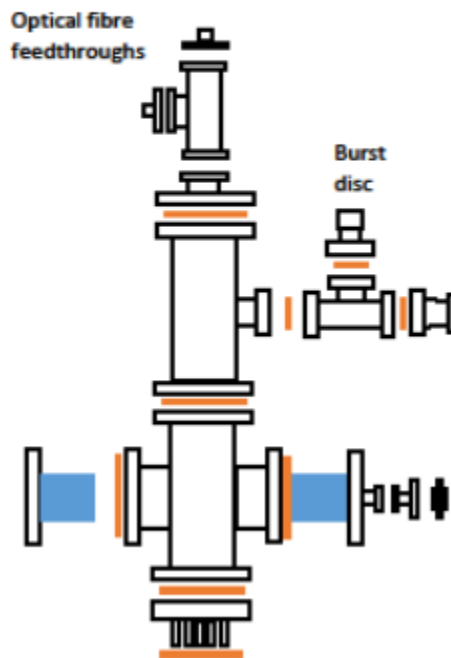


The power-over-fiber coupler box and FC-FC optical fiber coupler are shown below:




<https://www.fs.com/products/17537.html>

The copper power cable arrives through the Analog flange copper feedthrough. Analog flange relative position to the membrane-style module can be seen in the capture below.



Side view towards PD flanges

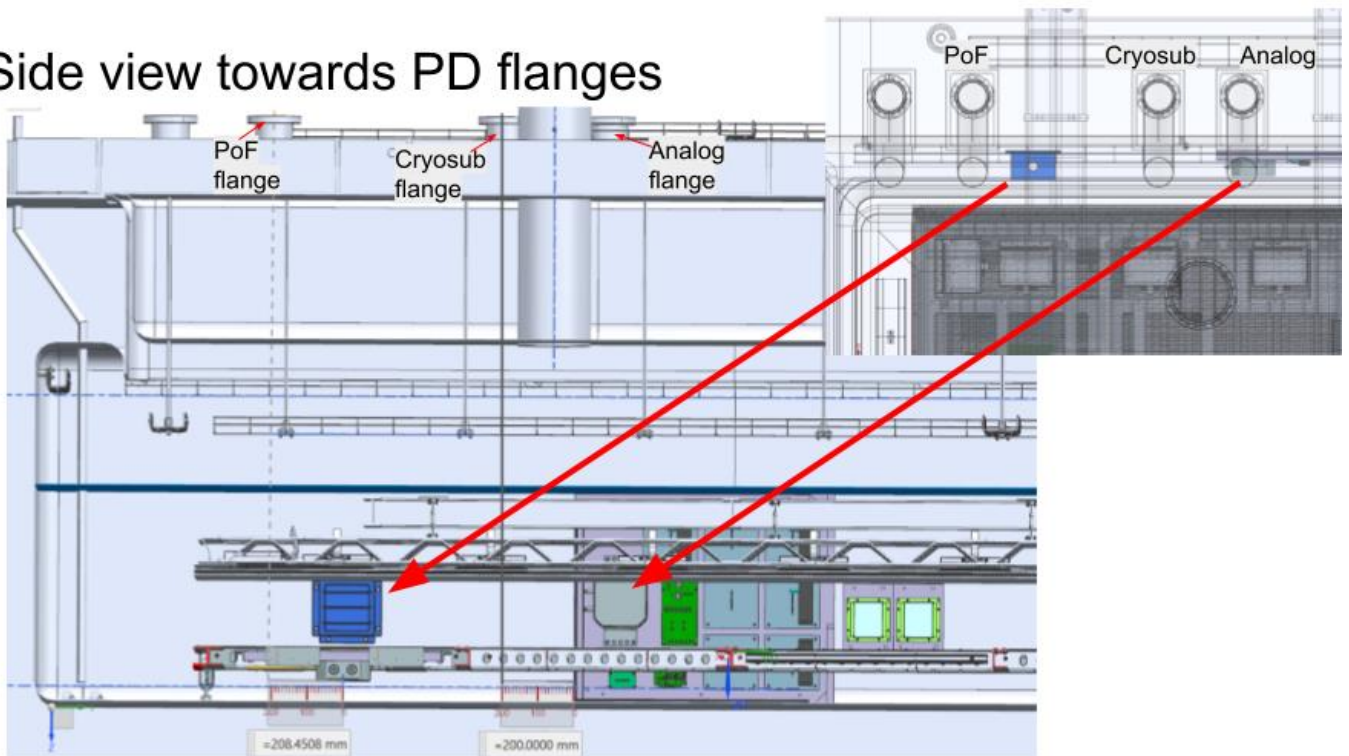


The analog flange is shown below with copper feedthrough's elevated chimney and two fiber feedthrough positions:

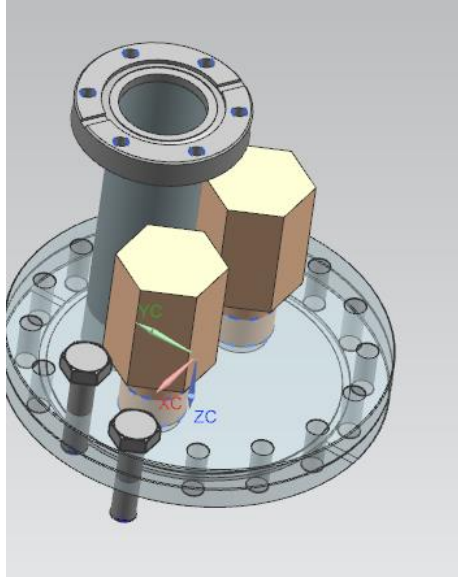

The optical feedthrough is shown in the image below – it is a ¾” feedthrough with either 8 signal fibers or 14 power-over-fiber fibers:

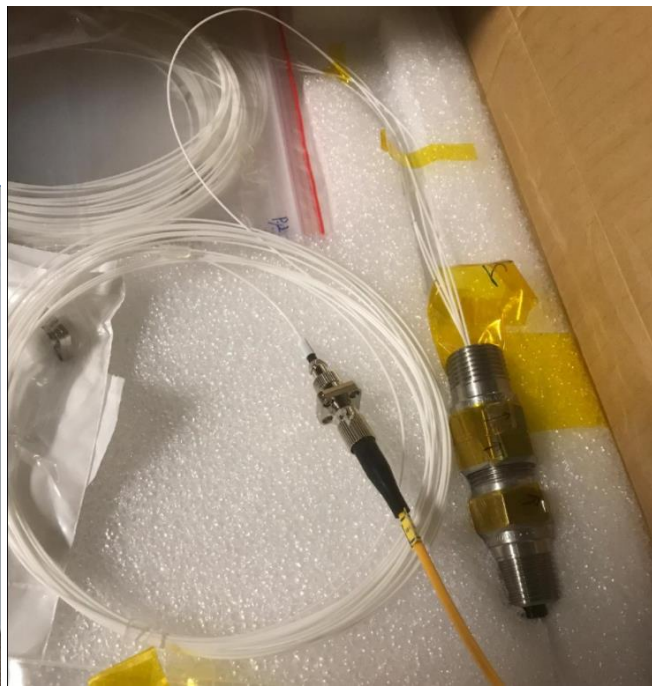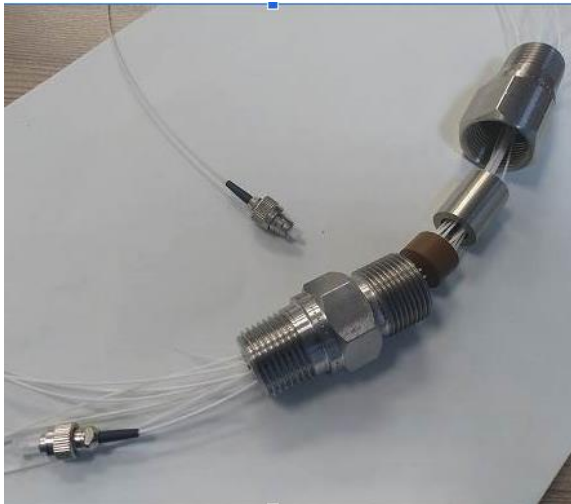

The copper cable used is the FD1 PDS Superior-Essex custom CAT-6 cable shown below. This cable is shielded with a drain wire, which will be connected at both ends to form a faraday cage penetration.

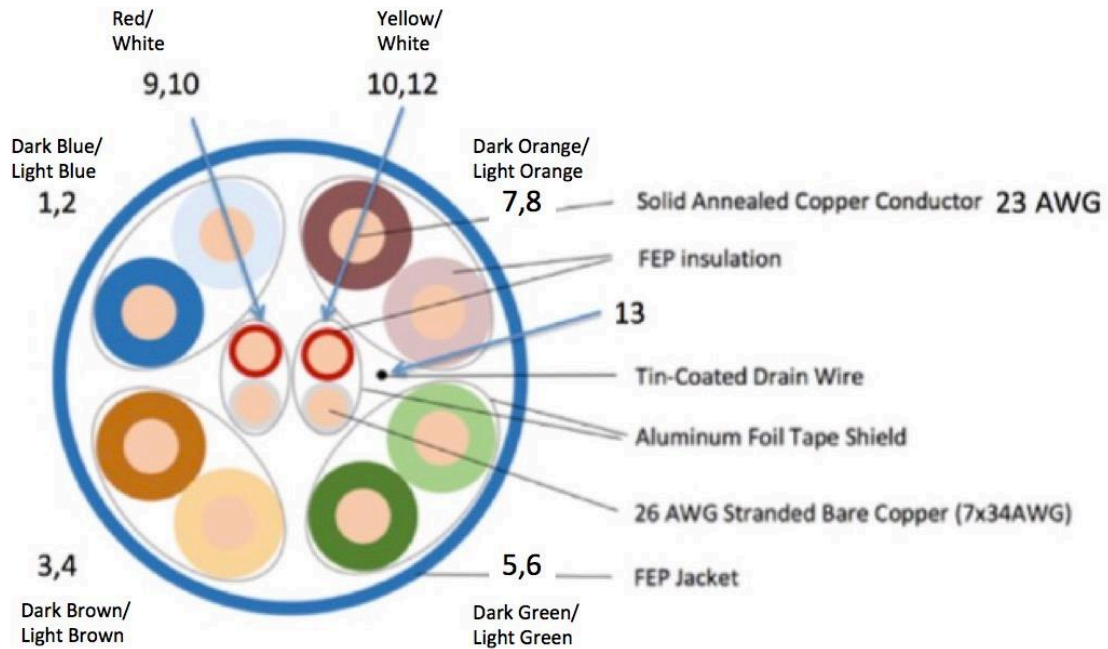

For the cold box installation, we will use the four 23 AWG pairs only as this simple passive feedthrough does not connect the internal 26 AWG pairs. The feedthrough is a passive pass through of the 8 outer conductors and the drain wire. We will have two feedthroughs on the flange for a total of 8 pairs and drain wire as shown in the image below.



Three separate low-voltage supplies of 100mA @ 5.5V will be over Dark Blue/Light Blue (1,2), Dark Brown/Light Brown (3,4), and Dark Green/Light Green (5,6) of the first feedthrough. Two bias supplies of

100nA @ 35V will be over Dark Blue/Light Blue (1,2) and Dark Brown/Light Brown (3,4) of the second feedthrough.

This simple passive test feedthrough was already used at CERN for test of ARAPUCAs with xenon at Horizontal Drift ProtoDUNE1.

The copper cable will have a male cable end plug as shown below:



HR10A-10P-12PC(73)

[Datasheet](#)

Digi-Key Part Number	HR1674-ND
Manufacturer	Hirose Electric Co Ltd
Manufacturer Part Number	HR10A-10P-12PC(73)
Description	CONN PLUG HSG MALE 12POS INLINE
Manufacturer Standard Lead Time	12 Weeks
Detailed Description	12 Position Circular Connector Plug Housing Free Hanging (In-Line) Backshell, Cable Clamp, Strain Relief

The flange has a female PCB mount receptacle as shown below:



HR10A-10R-12SB(71)

[Datasheet](#)

Digi-Key Part Number	HR1647-ND
Manufacturer	Hirose Electric Co Ltd
Manufacturer Part Number	HR10A-10R-12SB(71)
Description	CONN RCPT FEMALE 12POS SOLDER
Manufacturer Standard Lead Time	12 Weeks
Detailed Description	12 Position Circular Connector Receptacle, Female Sockets Solder

Here is the male crimp pin for Hirose connectors:



HR10-PC-112

[Datasheet](#) ↓

Digi-Key Part Number	HR451-ND
Manufacturer	Hirose Electric Co Ltd
Manufacturer Part Number	HR10-PC-112
Description	CONTACT PIN 26-30AWG CRIMP SLVR
Manufacturer Standard Lead Time	12 Weeks
Detailed Description	Pin Contact 26-30 AWG Size 1.0mm Crimp Silver

Here is the female crimp pin for Hirose connectors:




HR12-SC-112




[Datasheet](#) ↓

Digi-Key Part Number	HR453-ND
Manufacturer	Hirose Electric Co Ltd
Manufacturer Part Number	HR12-SC-112
Description	CONTACT SOCKET 26-30AWG CRIMP
Manufacturer Standard Lead Time	12 Weeks
Detailed Description	Socket Contact 26-30 AWG Size 1.0mm Crimp Silver












The schematics for the ARGON2 analog readout and the Interface PCB are attached at the end of this document.

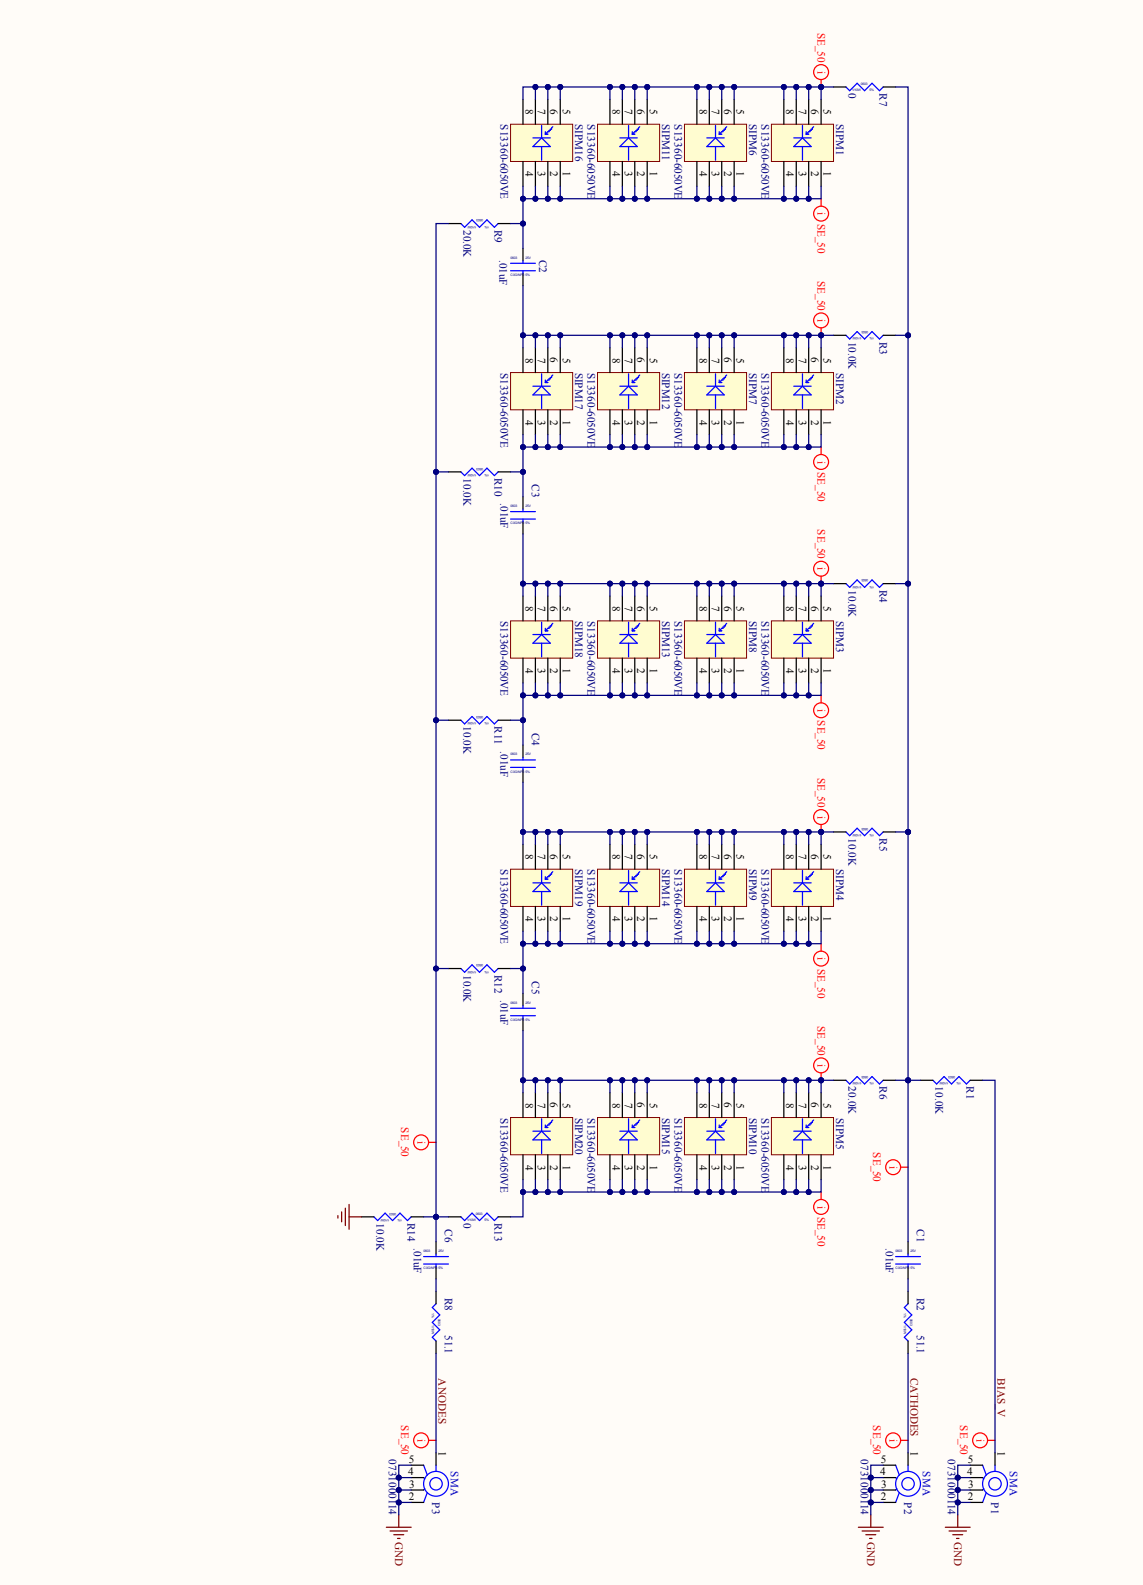

Title DUNE-1D Test		Fermilab	
Spec Rev Number	1	Engineer Greg Kuehling	Fermilab
Drawn Greg Kuehling		United States Department of Energy	
Date 10/2021		Fermilab	
File: C:\Projects\SIEM\DUNE_VD_Test\Altium\Ken\1\DUNE_VD_Test.SchDoc			

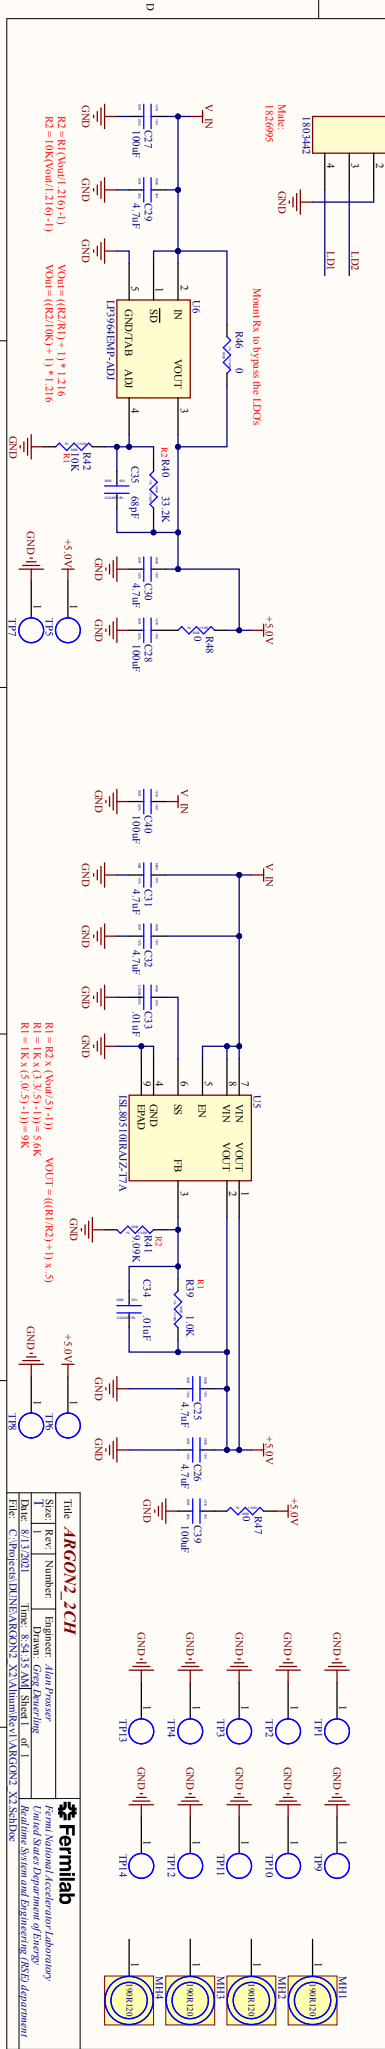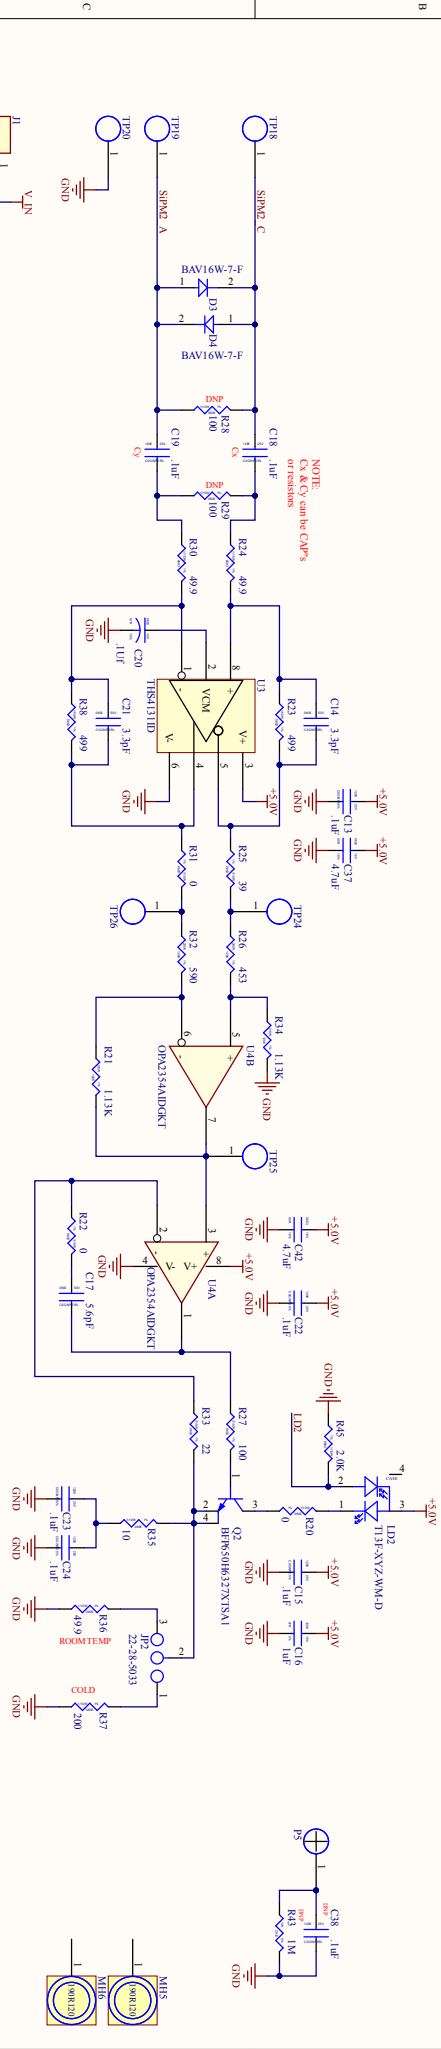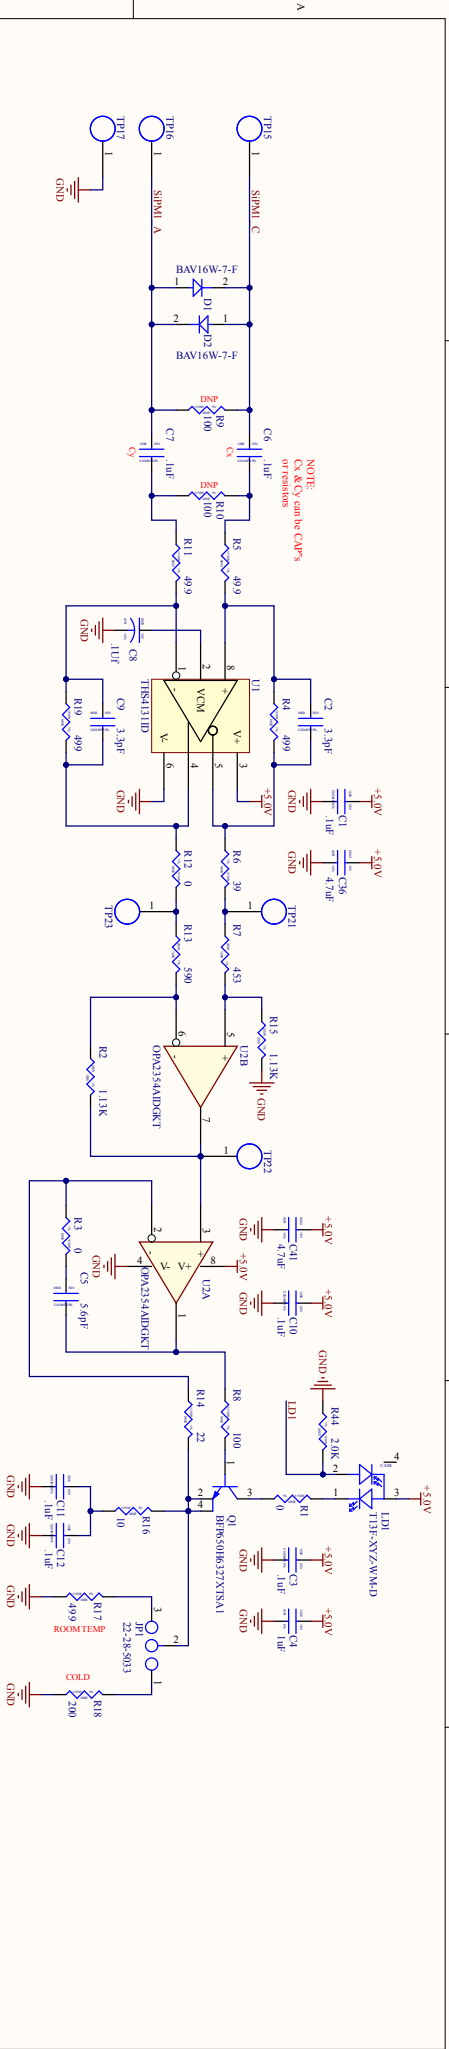

Title: ARGON2 2CH			
Sheet:	Rev:	Number:	Engineer: Alan Prosser
Date:	8/13/2021	Time:	8:34:35 AM
Drawn: Greg Kaveling			
Checked: Chris D. Linn			
Approved: Chris D. Linn			
Project: Argon2 2CH			
Revision: System and Substrate (DS2) department			
Scale: 1:1			

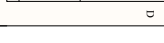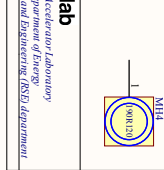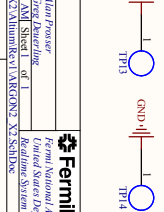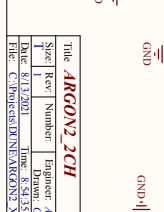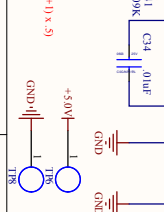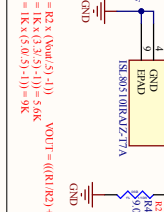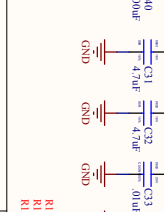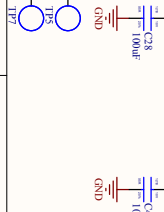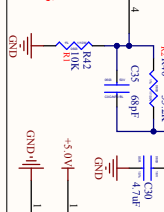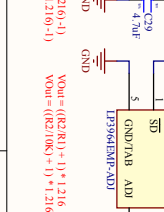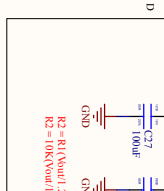

Make: FS3995

Mount R8 to depress the DDOs

$R2 = R1 \cdot (\text{Nom}(1) - 1)$
 $R2 = 10K \cdot (\text{Nom}(1.2) - 1)$

$\text{Vout} = \frac{V_{IN}}{1 + \frac{R1}{R2}}$
 $\text{Vout} = \frac{5.0V}{1 + \frac{10K}{10K \cdot 1.2}}$

$R1 = R2 \cdot (\text{Nom}(5) + 1)$
 $R1 = 1K \cdot (\frac{5.0V}{1.5} + 1) = 5.6K$

$R1 = R2 \cdot (\text{Nom}(5) - 1)$
 $R1 = 1K \cdot (\frac{5.0V}{1.5} - 1) = 9K$












$R1 = R2 \cdot (\text{Nom}(5) + 1)$
 $R1 = 1K \cdot (\frac{5.0V}{1.5} + 1) = 5.6K$

$R1 = R2 \cdot (\text{Nom}(5) - 1)$
 $R1 = 1K \cdot (\frac{5.0V}{1.5} - 1) = 9K$

$R1 = R2 \cdot (\text{Nom}(5) + 1)$
 $R1 = 1K \cdot (\frac{5.0V}{1.5} + 1) = 5.6K$

$R1 = R2 \cdot (\text{Nom}(5) - 1)$
 $R1 = 1K \cdot (\frac{5.0V}{1.5} - 1) = 9K$

$R1 = R2 \cdot (\text{Nom}(5) + 1)$
 $R1 = 1K \cdot (\frac{5.0V}{1.5} + 1) = 5.6K$

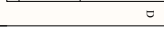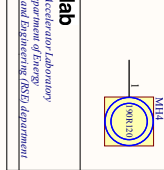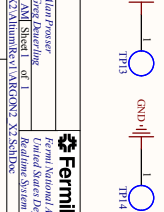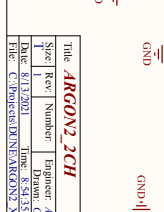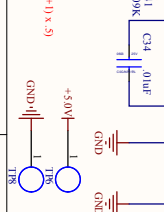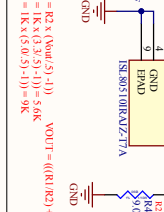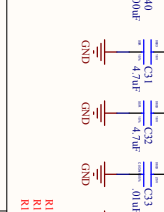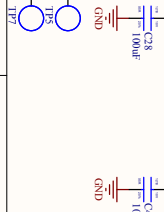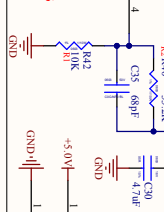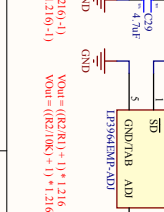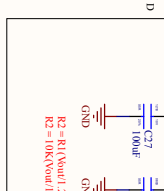

Make: FS3995

Mount R8 to depress the DDOs

$R2 = R1 \cdot (\text{Nom}(1) - 1)$
 $R2 = 10K \cdot (\text{Nom}(1.2) - 1)$

$\text{Vout} = \frac{V_{IN}}{1 + \frac{R1}{R2}}$
 $\text{Vout} = \frac{5.0V}{1 + \frac{10K}{10K \cdot 1.2}}$

$R1 = R2 \cdot (\text{Nom}(5) + 1)$
 $R1 = 1K \cdot (\frac{5.0V}{1.5} + 1) = 5.6K$

$R1 = R2 \cdot (\text{Nom}(5) - 1)$
 $R1 = 1K \cdot (\frac{5.0V}{1.5} - 1) = 9K$

$R1 = R2 \cdot (\text{Nom}(5) + 1)$
 $R1 = 1K \cdot (\frac{5.0V}{1.5} + 1) = 5.6K$

$R1 = R2 \cdot (\text{Nom}(5) - 1)$
 $R1 = 1K \cdot (\frac{5.0V}{1.5} - 1) = 9K$


$R1 = R2 \cdot (\text{Nom}(5) + 1)$
 $R1 = 1K \cdot (\frac{5.0V}{1.5} + 1) = 5.6K$

$R1 = R2 \cdot (\text{Nom}(5) - 1)$
 $R1 = 1K \cdot (\frac{5.0V}{1.5} - 1) = 9K$

$R1 = R2 \cdot (\text{Nom}(5) + 1)$
 $R1 = 1K \cdot (\frac{5.0V}{1.5} + 1) = 5.6K$

N.B. CAREFUL LAYOUT!
NEED TO REDUCE EMI LEAKAGE
AS MUCH AS POSSIBLE







TANTALUM CAPS
ACT AS ENERGY RESERVOIR WHILE
FPGA IS CONFIGURING

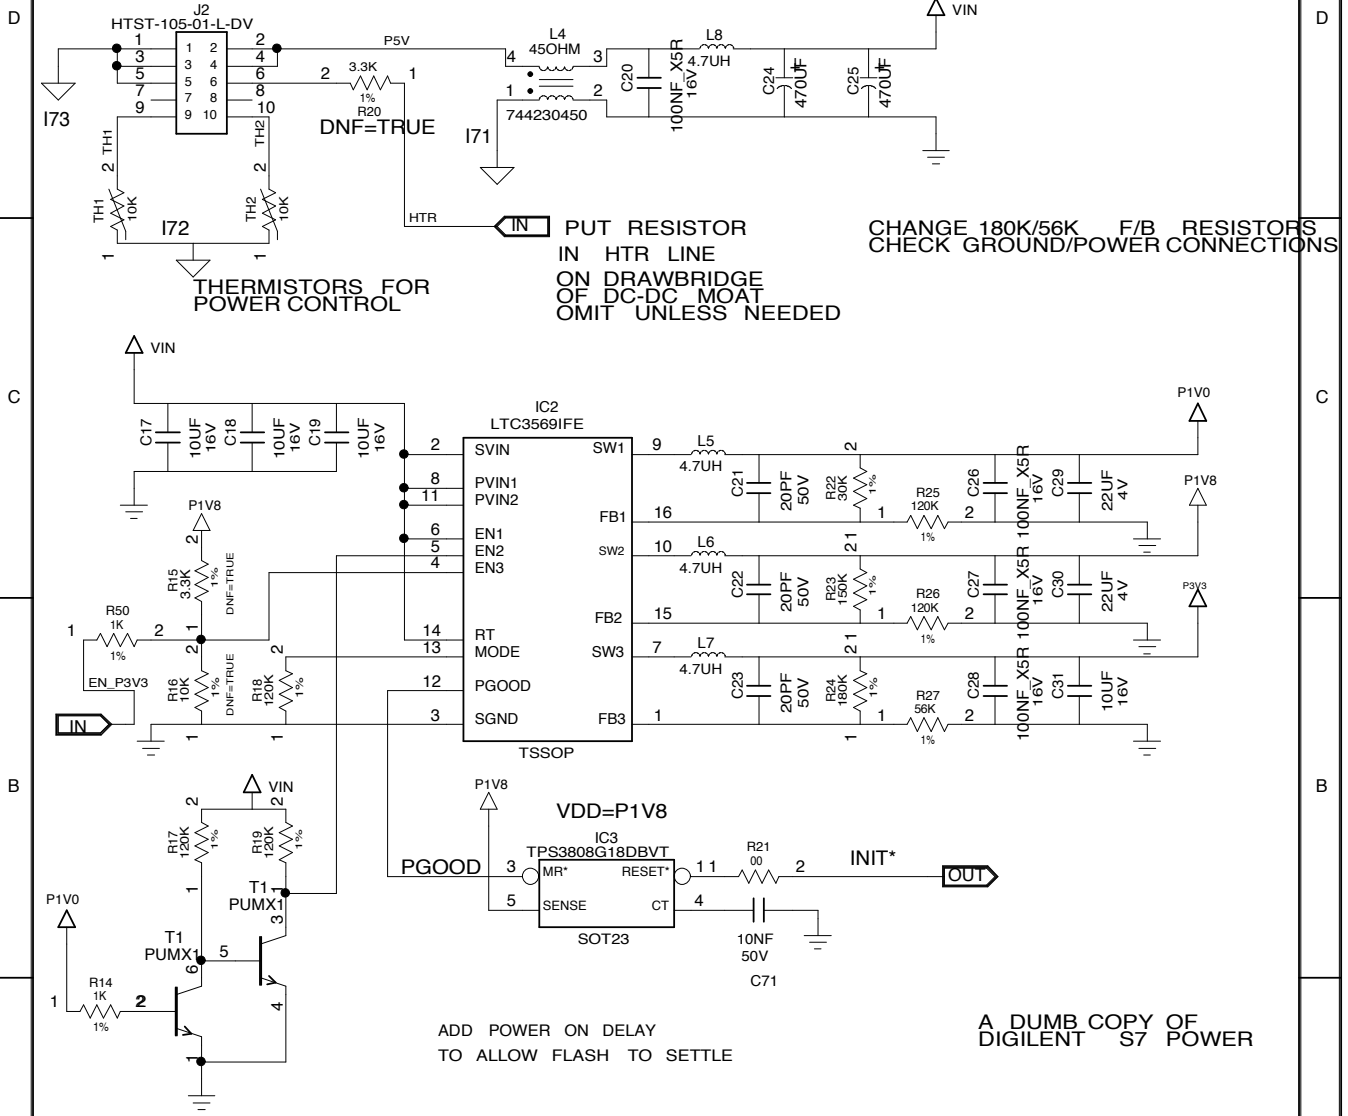

TITLE:	POWER SUPPLY	DATE:	JUNE 21
ENGINEER:	D.CUSSANS	PAGE:	


USE TOGETHER WITH
CLP-104-02-F-D-TR

COMMON MODE CHOKE
AT AIN TO REDUCE
NOISE LEAKING OUT
OF BOX

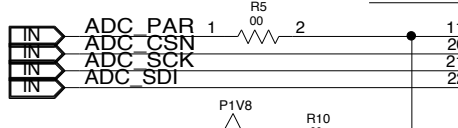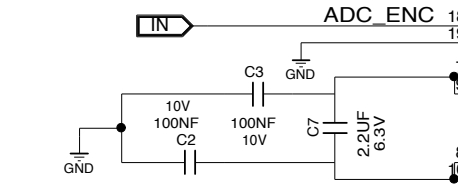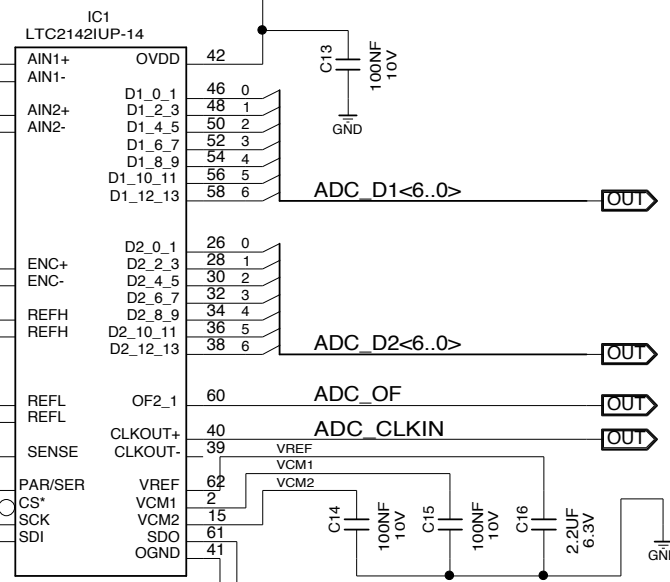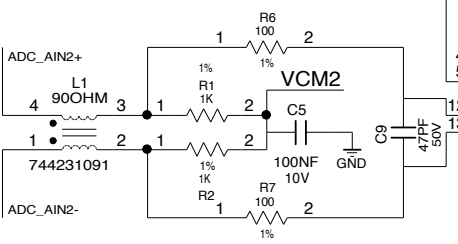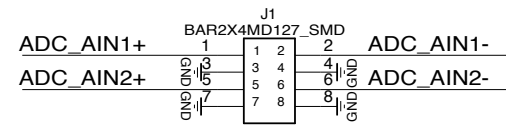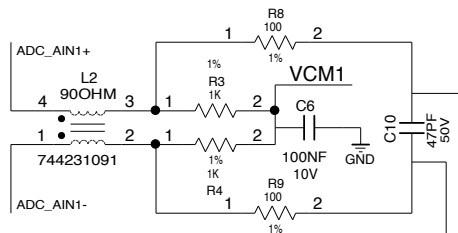

FIT *EITHER* PULL-UP
OR PULL-DOWN
OR NEITHER.


SELECT VOLTAGE AT
VSENSE TO SELECT
FULL-SCALE RANGE

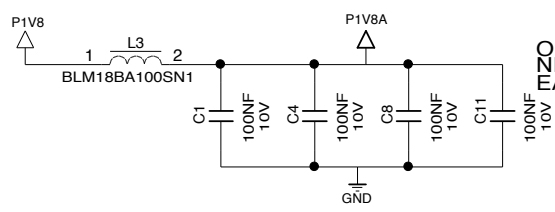


ONE CAP
NEXT TO
EACH VDD PIN

TITLE: ADC	DATE:
ENGINEER:	PAGE:


ASSEMBLE CRYSTAL AND CONNECT VCTR
 AND OMIT LINK TO EXTERNAL CLOCK FOR VXCO.
 FIT LINK TO EXTERNAL CLOCK AND OMIT CRYSTAL
 AND LINK TO CLK_PLL FOR USE AS CLOCK BUFFER/GEN

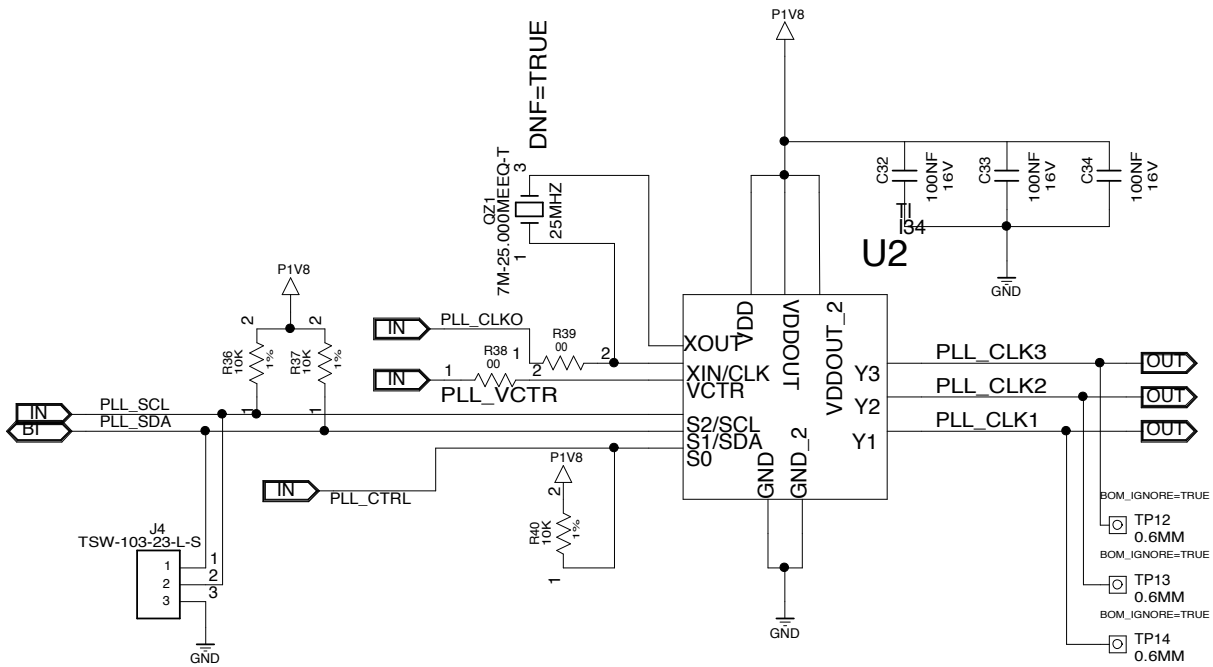


TITLE: PLL	DATE:
ENGINEER:	PAGE:

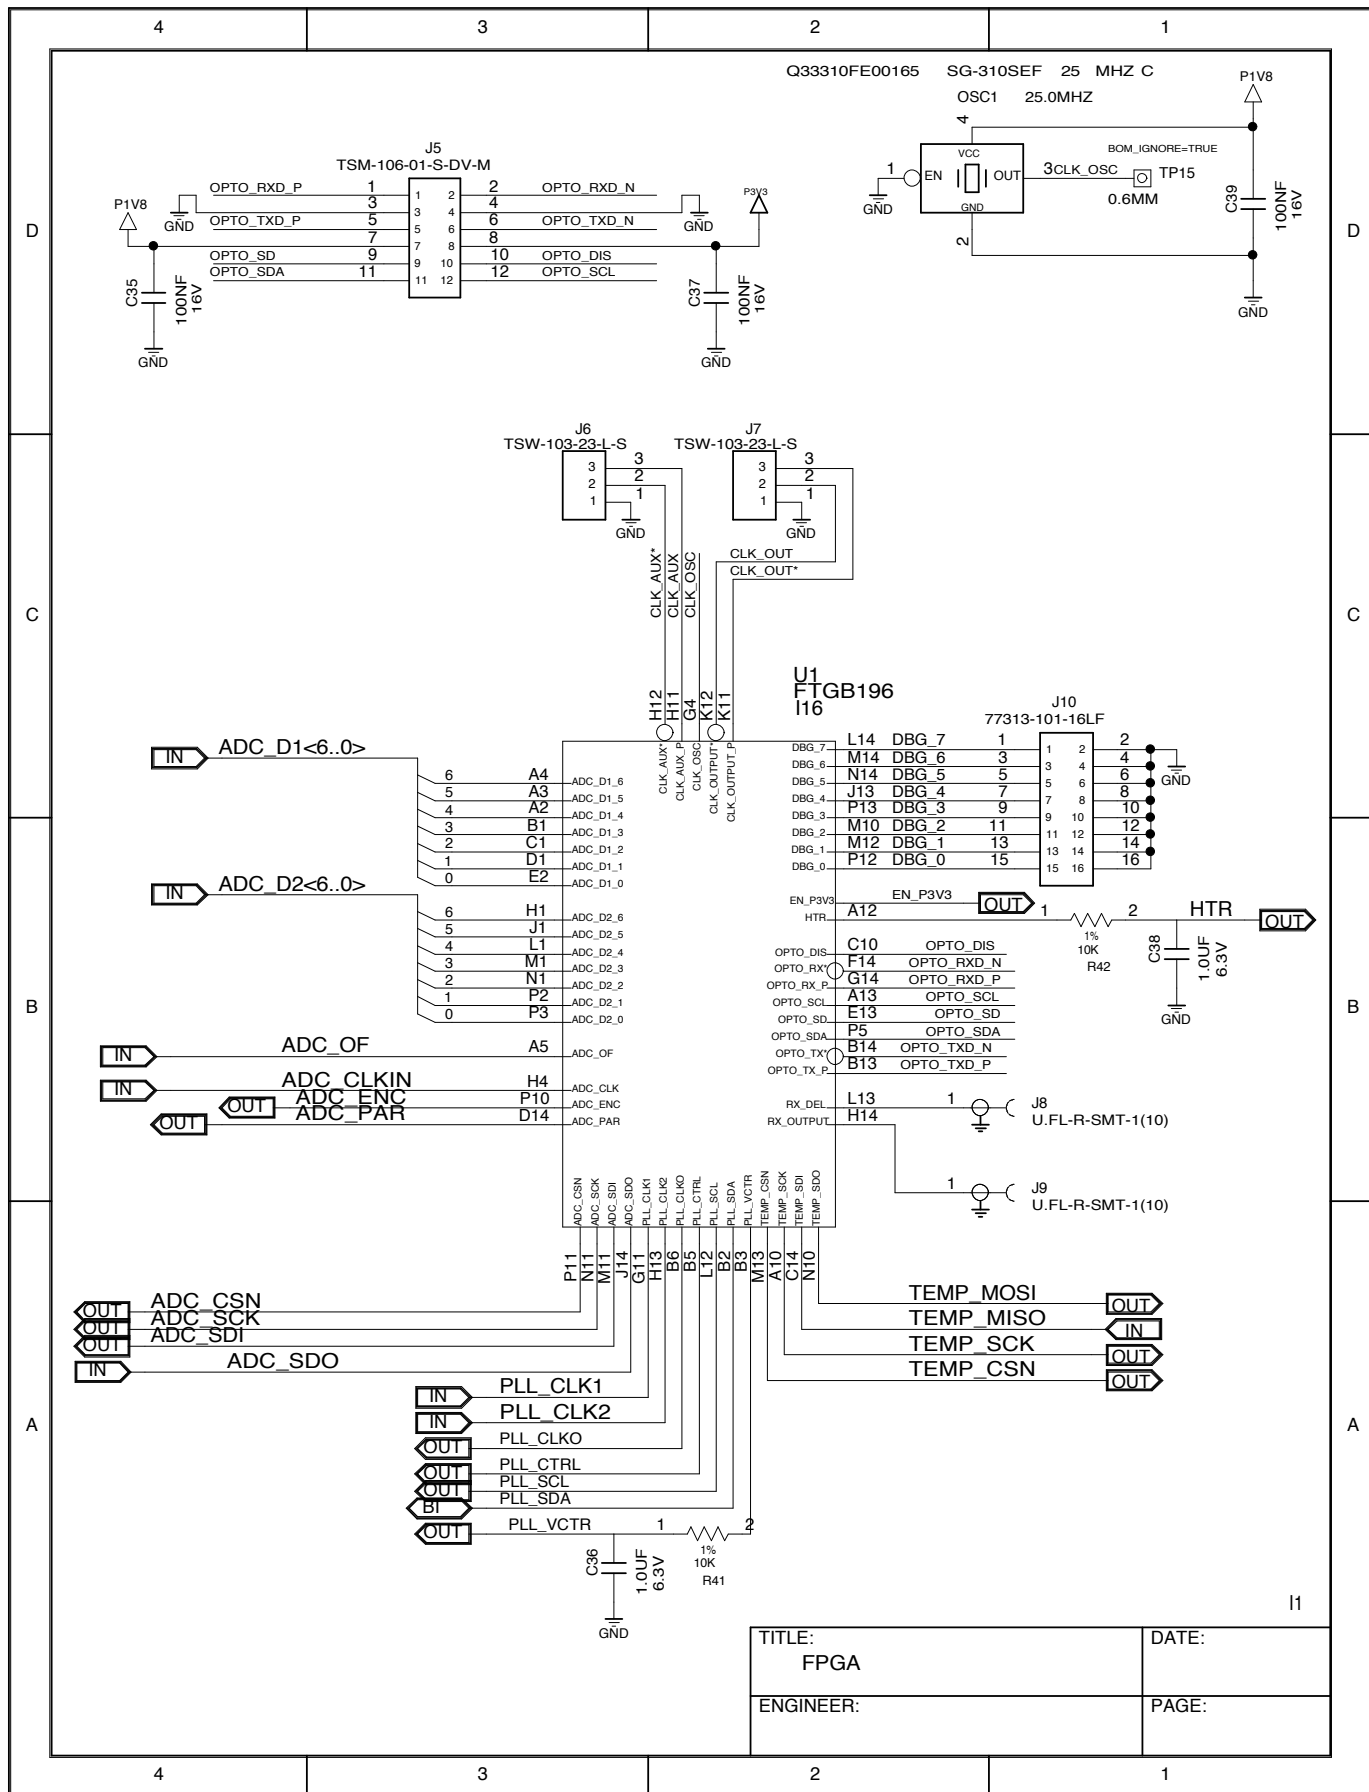


TITLE: FPGA	DATE:
ENGINEER:	PAGE:

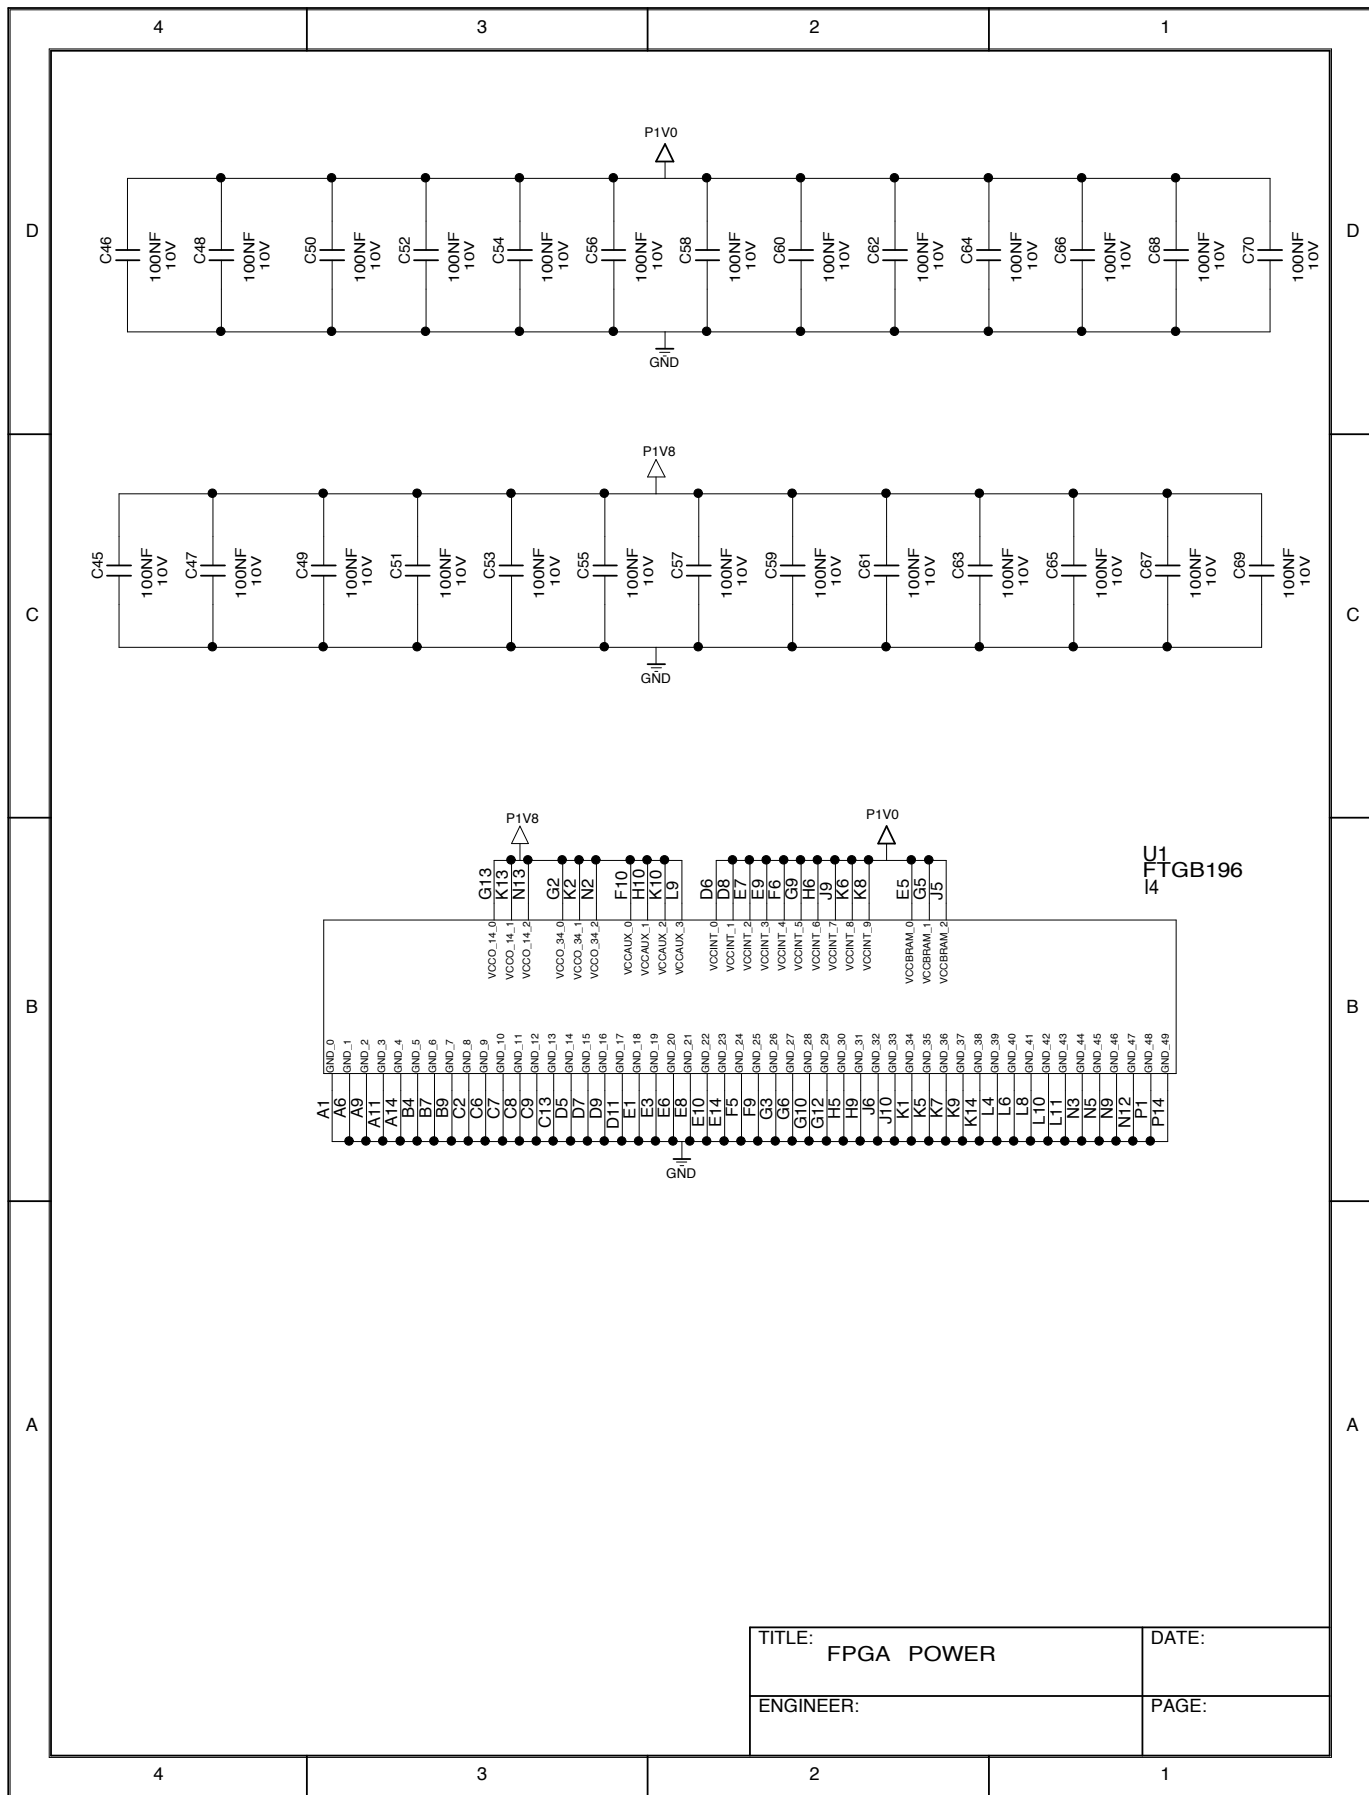

TITLE: FPGA POWER	DATE:
ENGINEER:	PAGE:

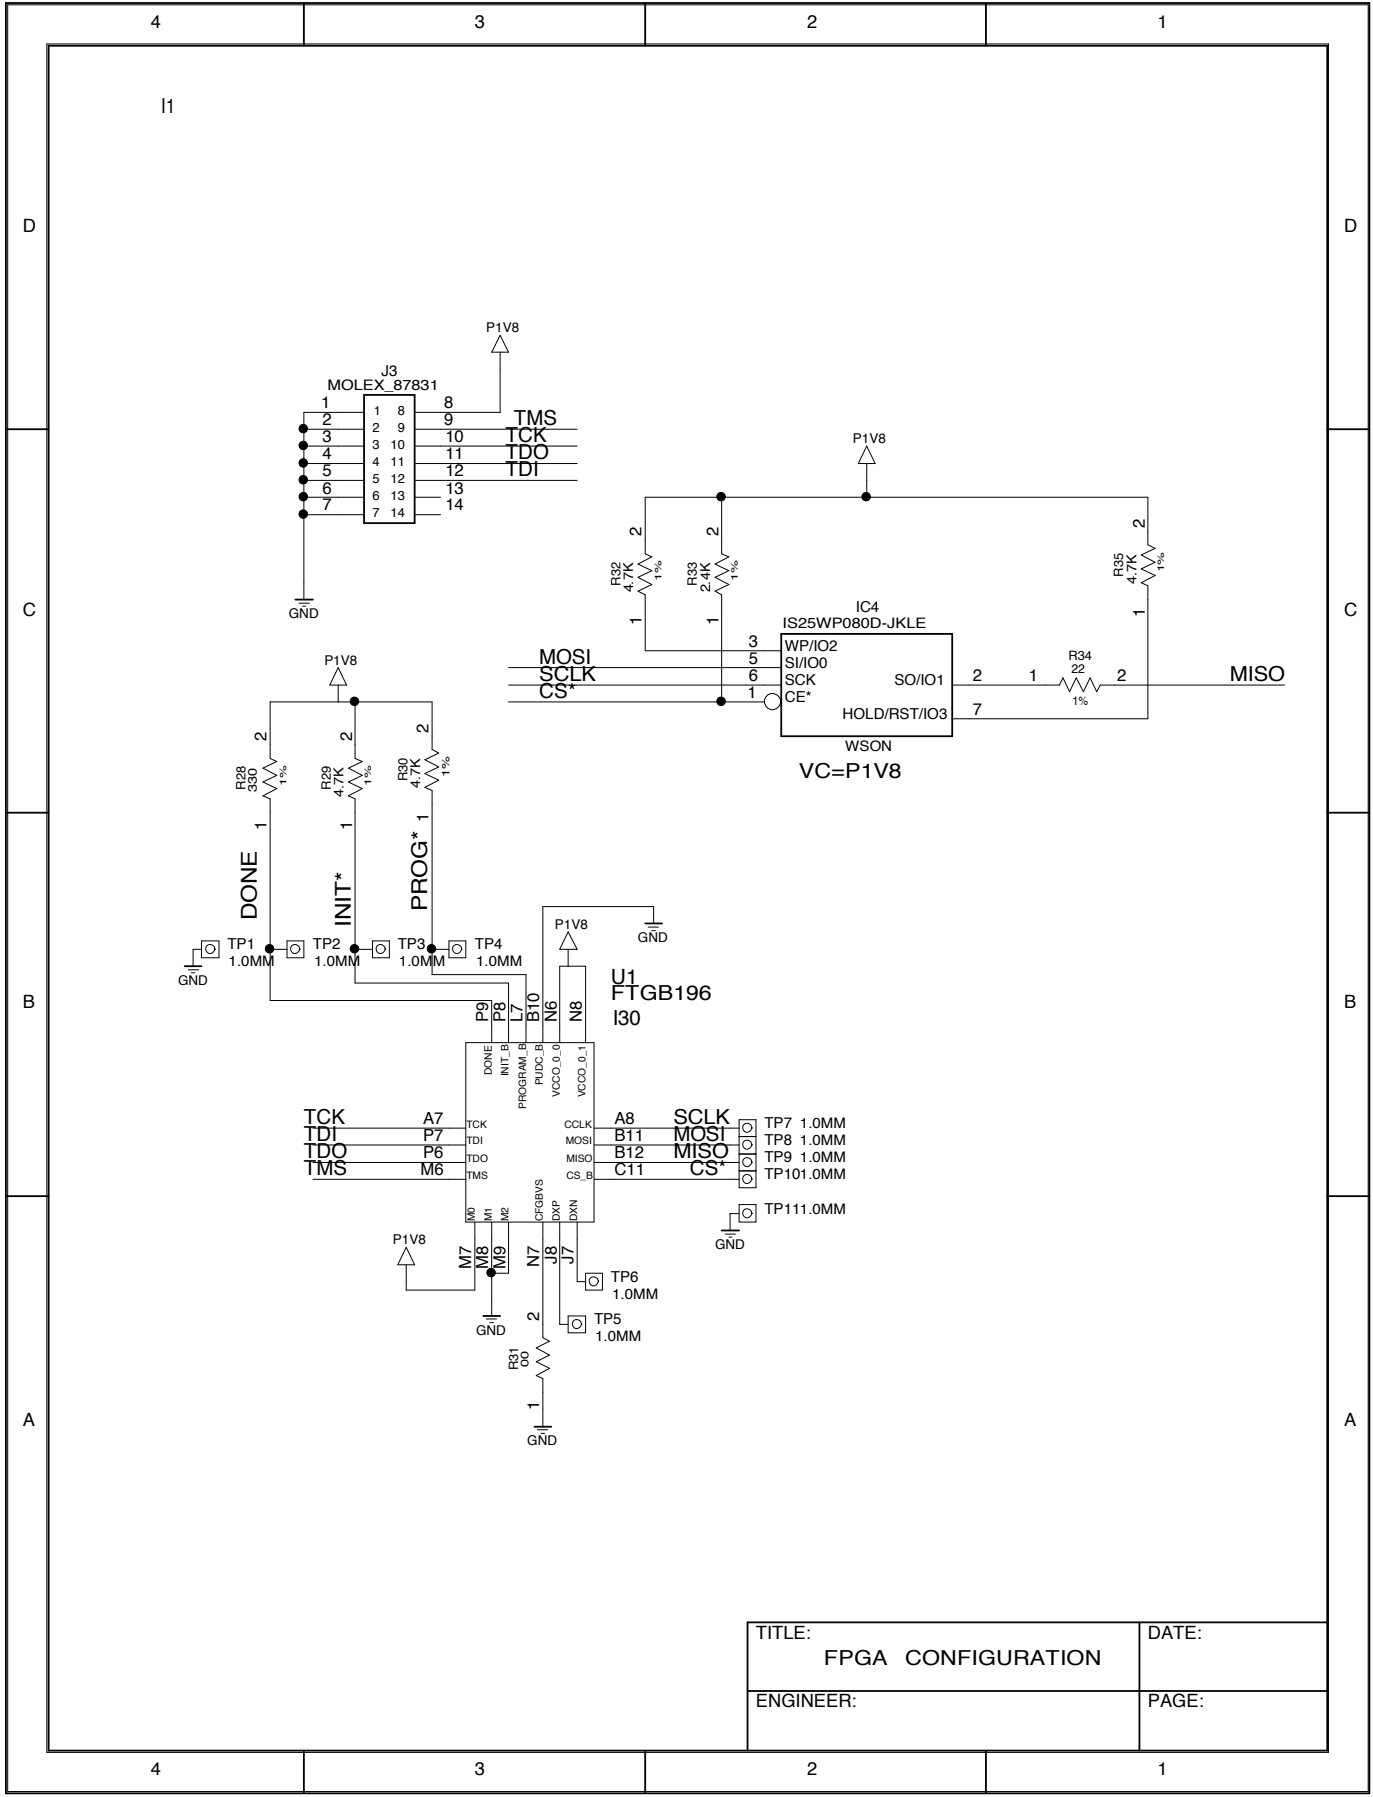

TITLE: FPGA CONFIGURATION	DATE:
ENGINEER:	PAGE:

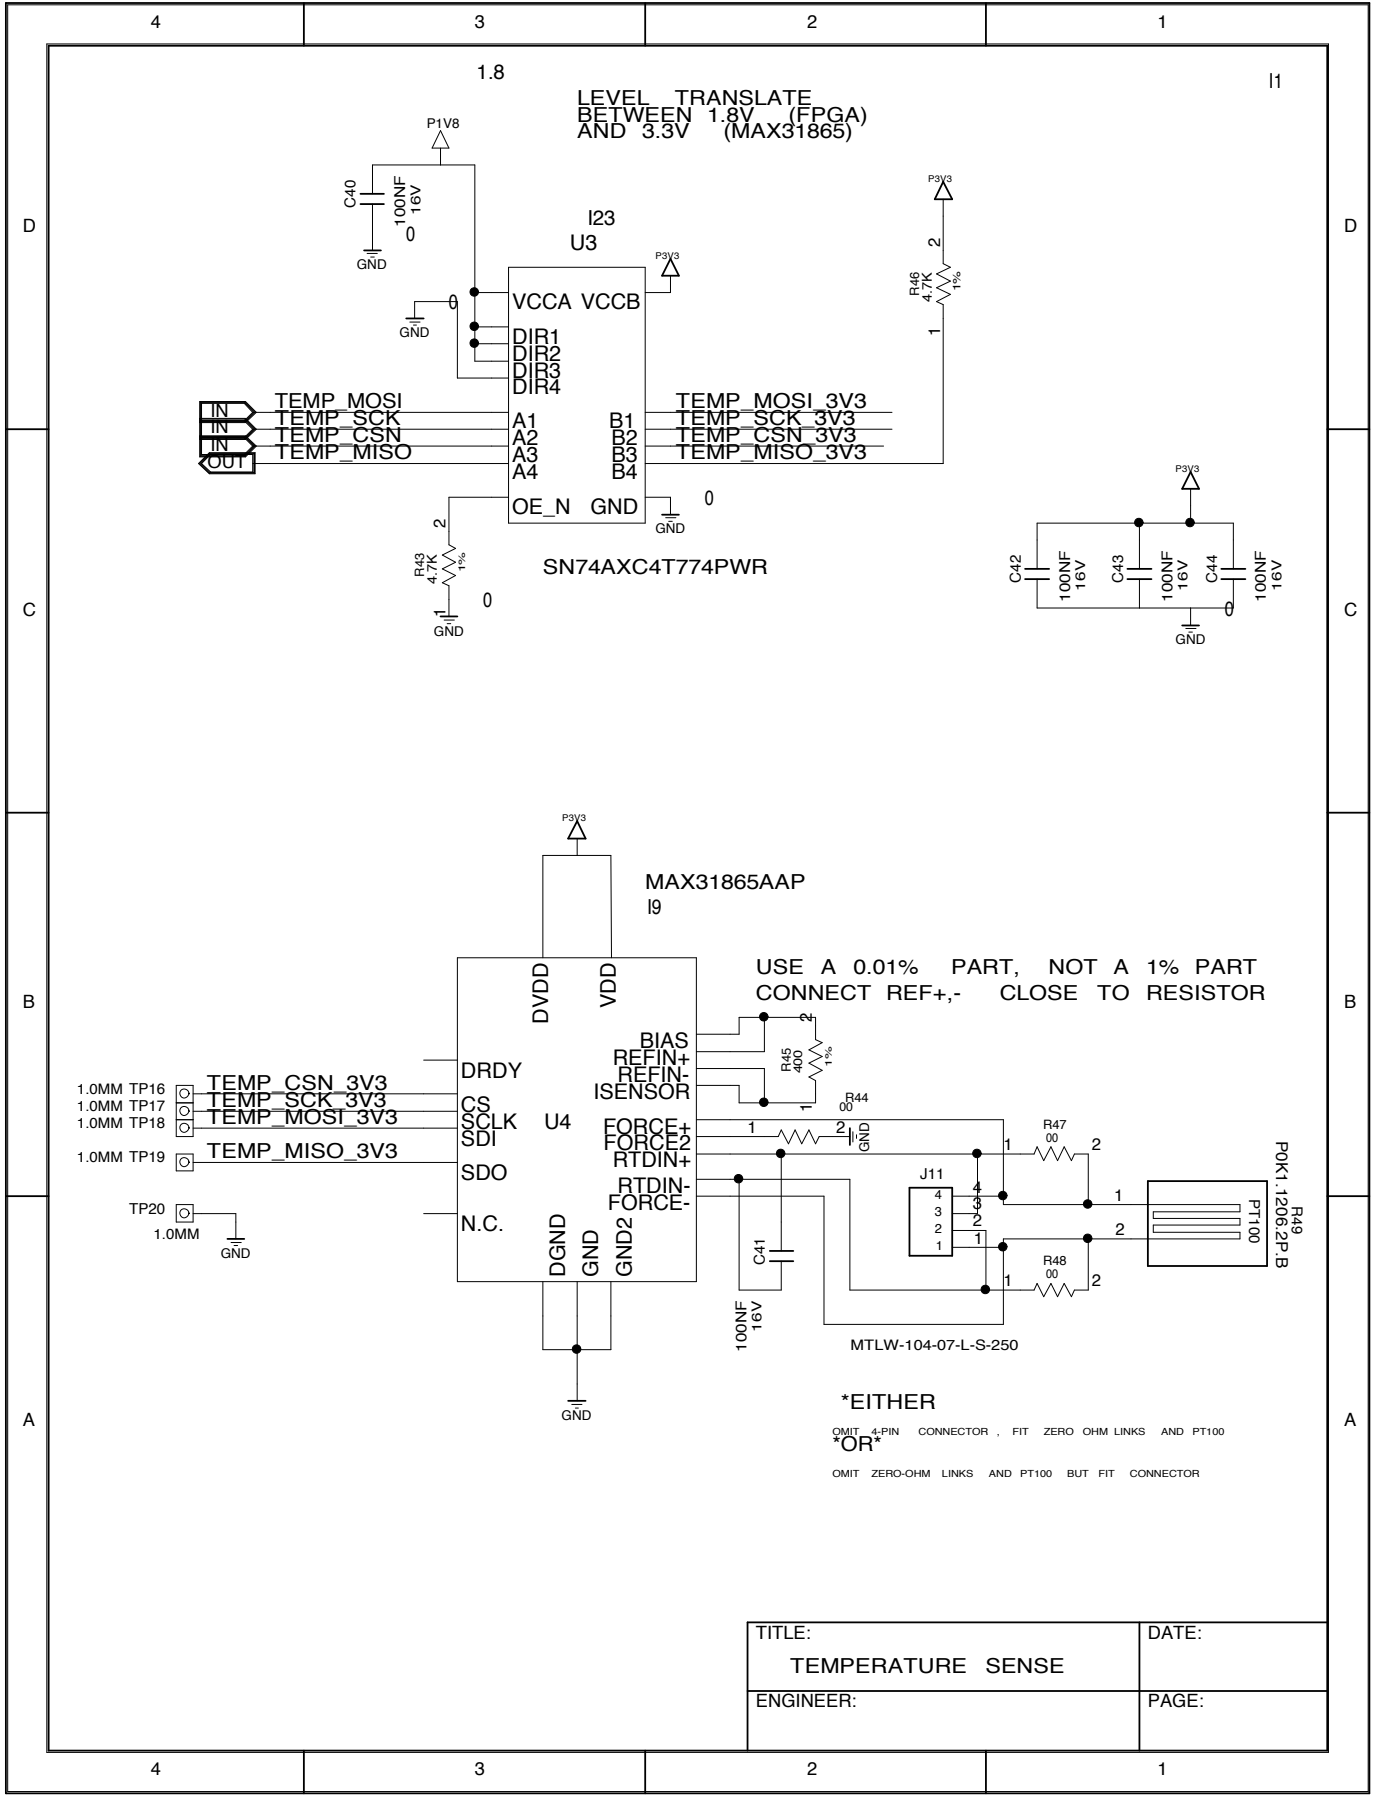

TITLE: TEMPERATURE SENSE	DATE:
ENGINEER:	PAGE: